

# CERTIFICATE OF LOCATION OF GOVERNMENT CORNER

County of Anoka

State of Minnesota


## South 1/4 Corner of Sec. 5 Township 31 Range 23

On the 30th day of November, 1959, the described corner was evidenced by a P.K. nail

and to perpetuate the location of said corner, at the exact location thereof, a permanent marker was placed consisting of a brass cap set flush in concrete bridge deck

AND on the 5th day of June, 2014, said permanent marker was found and the ties were updated

Updated reference ties are as shown below.

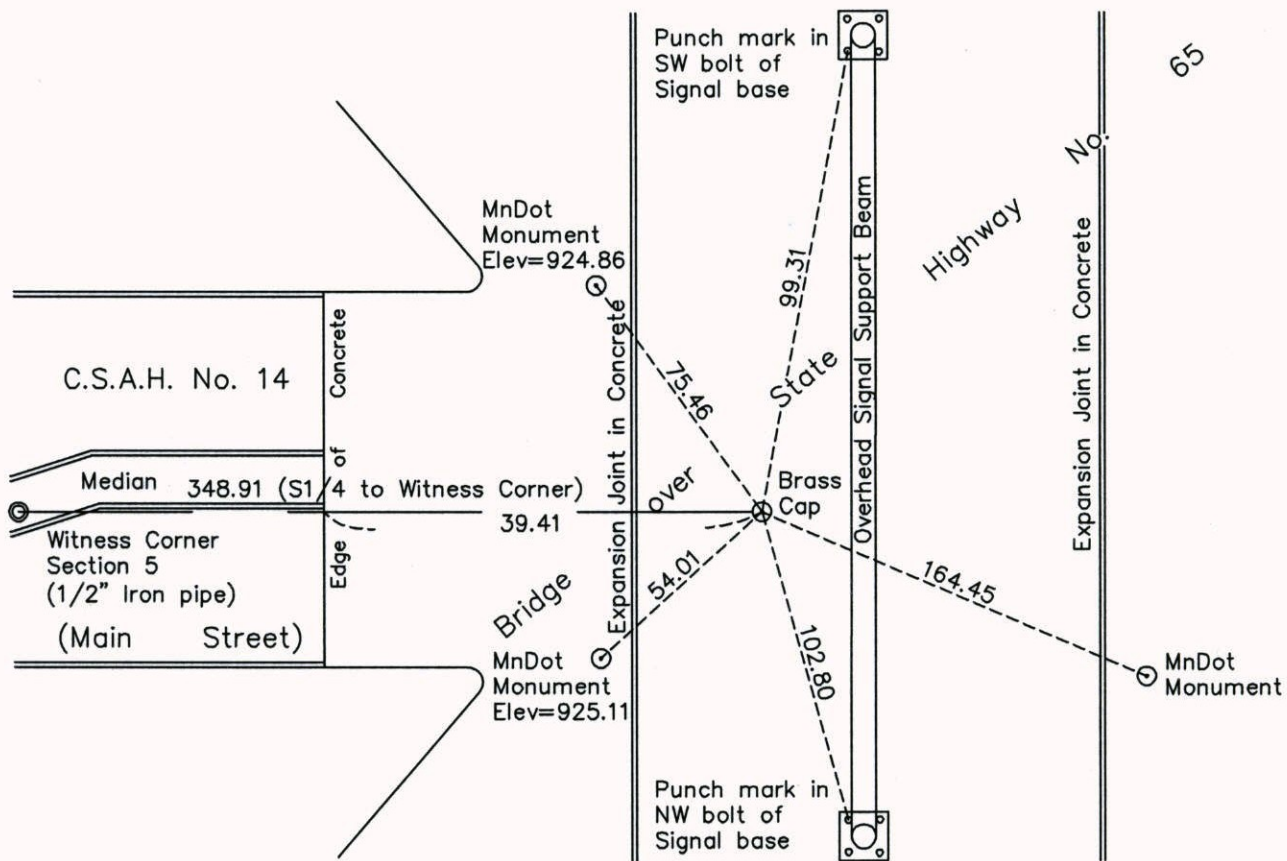

N.A.D. 1983 Coordinates  
(1996 Adjustment)

County Project Coordinates

Northing	159046.4624
Easting	508208.2586
Date	4/17/08

Revision Date  
12/24/14

I hereby certify that this United States public land survey monument record is correct and complete to the best of my knowledge and belief.

*Larry D. Hoium* Date 12/24/14  
 Larry D. Hoium, Anoka County Surveyor  
 Minnesota License Number 18165