

# CERTIFICATE OF LOCATION OF GOVERNMENT CORNER

County of Anoka

State of Minnesota


## West 1/4 Corner of Sec. 9 Township 31 Range 23

On the 26th day of July, 1960, the described corner was evidenced by an iron pipe

and to perpetuate the location of said corner, at the exact location thereof, a permanent marker was placed consisting of a cast iron monument with a sign and post on the north side

AND on the 3rd day of May, 2022, said permanent marker was found flush and the ties were updated

Updated reference ties are as shown below.

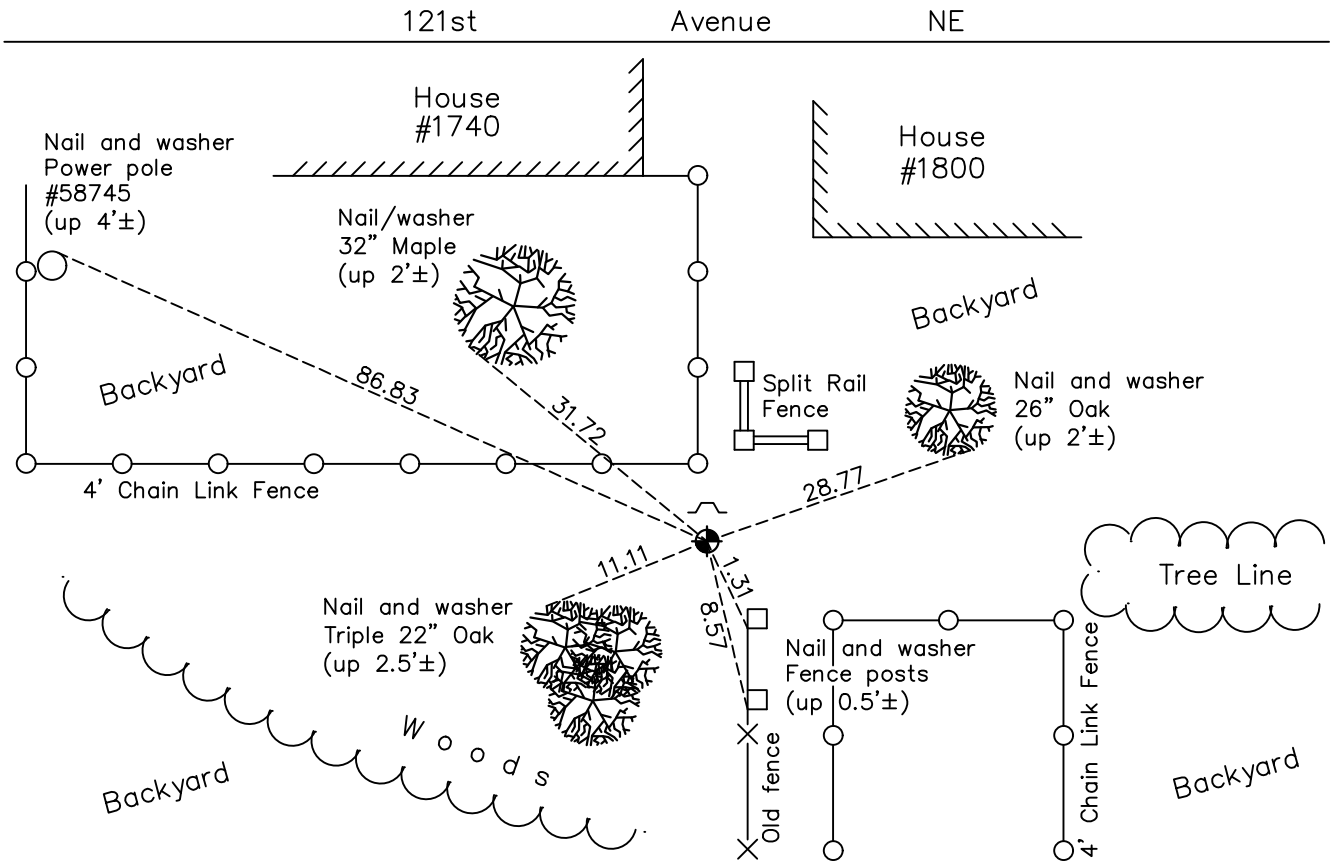

Revision Date  
7/14/2022

N.A.D. 1983 Coordinates  
(1996 Adjustment)

County Project Coordinates	
Northing	156402.1037
Easting	510842.8639
Date	10/12/98

I hereby certify that this United States public land survey monument record is correct and complete to the best of my knowledge and belief.  
*David Zieglmeier* Date 2/8/23  
 David Zieglmeier Anoka County Surveyor  
 Minnesota License Number 46179

# HISTORY OF GOVERNMENT CORNER

Page No. 33

County of Anoka

State of Minnesota

West 1/4 Corner of Sec. 9 Township 31 Range 23

## **CORNER HISTORY:**

July 26, 1960 - Found iron pipe flush and established ties to iron pipe.

March 5, 1962 - Set 3/4 inch iron pipe down 0.3' and updated ties.

August 7, 1968 - Found iron pipe down 0.3'± and updated ties.

September 2, 1971 - Found iron pipe and updated ties.

September 7, 1971 - Found iron pipe and replaced with a cast iron monument.

May 15, 1975 - Found cast iron monument and updated ties.

August 11, 1977 - Found cast iron monument and updated ties.

June 9, 1980 - Found cast iron monument and updated ties.

July 31, 1990 - Found cast iron monument and updated ties.

June 9, 1995 - Found cast iron monument and updated ties.

October 12, 1998 - Found cast iron monument, established NAD 1983 (1996 adj.) Anoka County project coordinates by static GPS methods and updated ties.

July 11, 2006 - Found cast iron monument and updated ties.

April 2014 - Found cast iron monument and updated ties.

June 18, 2019 - Found cast iron monument and updated ties.

May 3, 2022 - Found cast iron monument flush, verified position by GPS VRS methods and updated ties