

CERTIFICATE OF LOCATION OF GOVERNMENT CORNER

County of Anoka

State of Minnesota


North 1/4 Corner of Sec. 14 Township 31 Range 23

On the 18th day of January, 1965, the described corner was evidenced by area resurvey

and to perpetuate the location of said corner, at the exact location thereof, a permanent marker was placed consisting of a red and white 2" square steel Telspar monument

AND on the 9th day of March, 2023, said permanent marker was removed Telspar to set new 6' x 2" square steel Telspar set up 1'± w/ punched cap using County RTK GPS method.

Updated reference ties are as shown below.

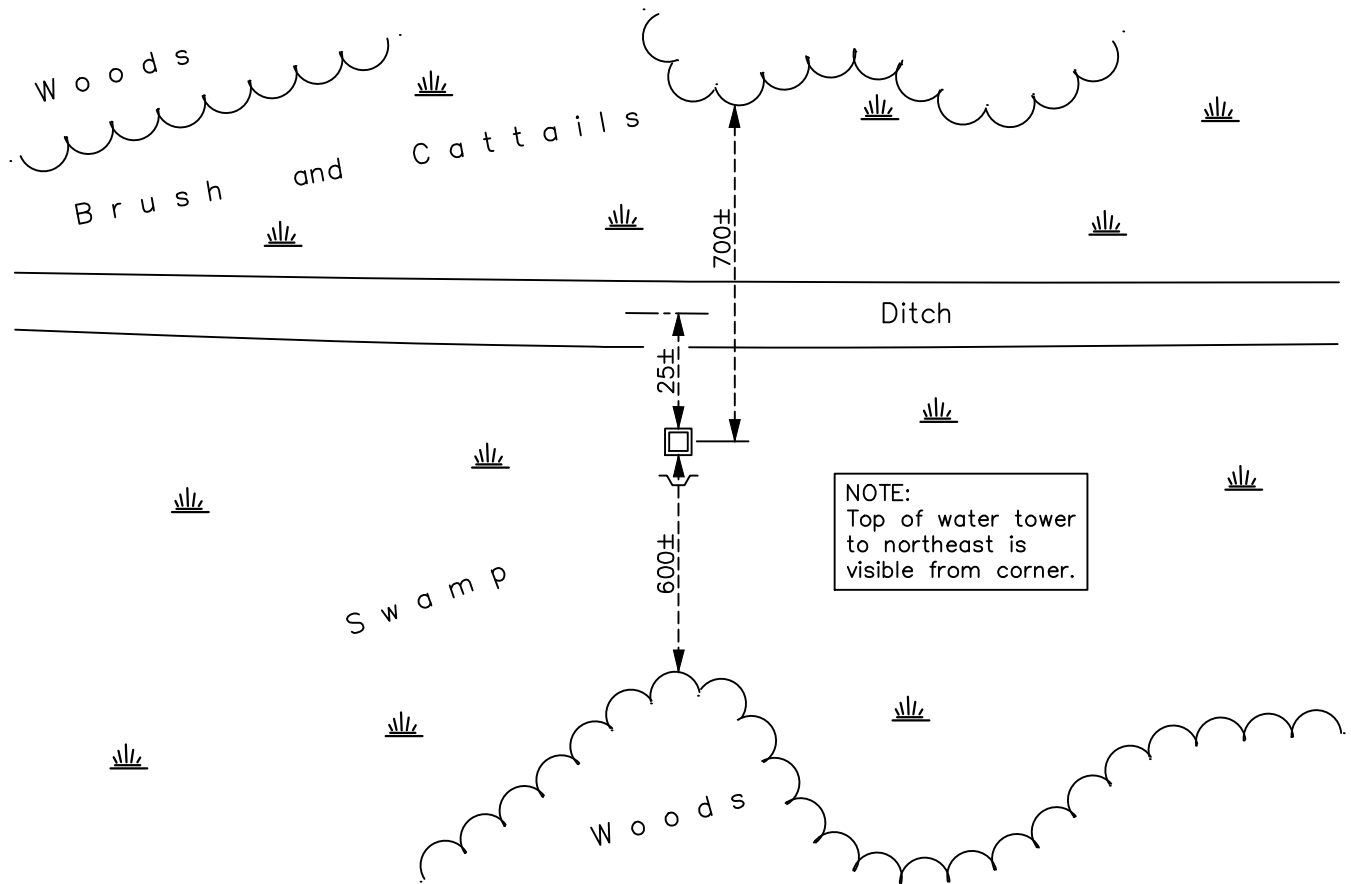

Revision Date

3/27/2023

N.A.D. 1983 Coordinates
(1996 Adjustment)

County Project Coordinates	
Northing	153562.7195
Easting	524060.1406
Date	11/15/99

I hereby certify that this United States public land survey monument record is correct and complete to the best of my knowledge and belief.

David Zieglermeier Date 4/4/23

David M. Zieglermeier, Anoka County Surveyor
Minnesota License Number 46179

HISTORY OF GOVERNMENT CORNER

Page No. 41

County of Anoka

State of Minnesota

North 1/4 Corner of Sec. 14 Township 31 Range 23

CORNER HISTORY:

January 18, 1965 - Set 1" x 12' red and white iron pipe using area resurvey and established ties to iron pipe.

January 15, 1974 - Found red and white iron pipe up 3.5'.

January 15, 1988 - Found red and white iron pipe and updated ties.

November 15, 1999 - Found red and white 2" square steel Telspar monument. Established NAD 1983 (1996 adj.) Anoka County project coordinates by static GPS methods. Corner ties not available.

July 29, 2014 - Found red and white 2" square steel Telspar monument leaning slightly northwest. Verified position by VRS GPS methods. Corner ties not available.

January 11, 2022 - Found red and white 2" square steel Telspar monument leaning slightly northwest. Verified position by VRS GPS methods. Corner ties not available.

March 9, 2023 - Removed red & white Telspar w/ Iron Pipe inside which was found leaning slightly and Replaced with a new 2" square steel Telspar and punch marked cap set up 1'± using County RTK GPS method. Added sign & post to the the South side, facing North. No ties available.