

# CERTIFICATE OF LOCATION OF GOVERNMENT CORNER

County of Anoka

State of Minnesota



## North 1/4 Corner of Sec. 15 Township 31 Range 23

On the 8th day of May, 2025, the described corner was evidenced by area resurvey

and to perpetuate the location of said corner, at the exact location thereof, a permanent marker was placed consisting of a new 1/2" rebar with "County Surveyor" cap with punch mark

AND on the 8th day of May, 2025, said permanent marker was set down 0.1'± using Static GPS method. Verified position by RTK GPS method. Established ties.

Updated reference ties are as shown below.

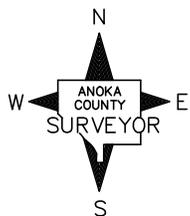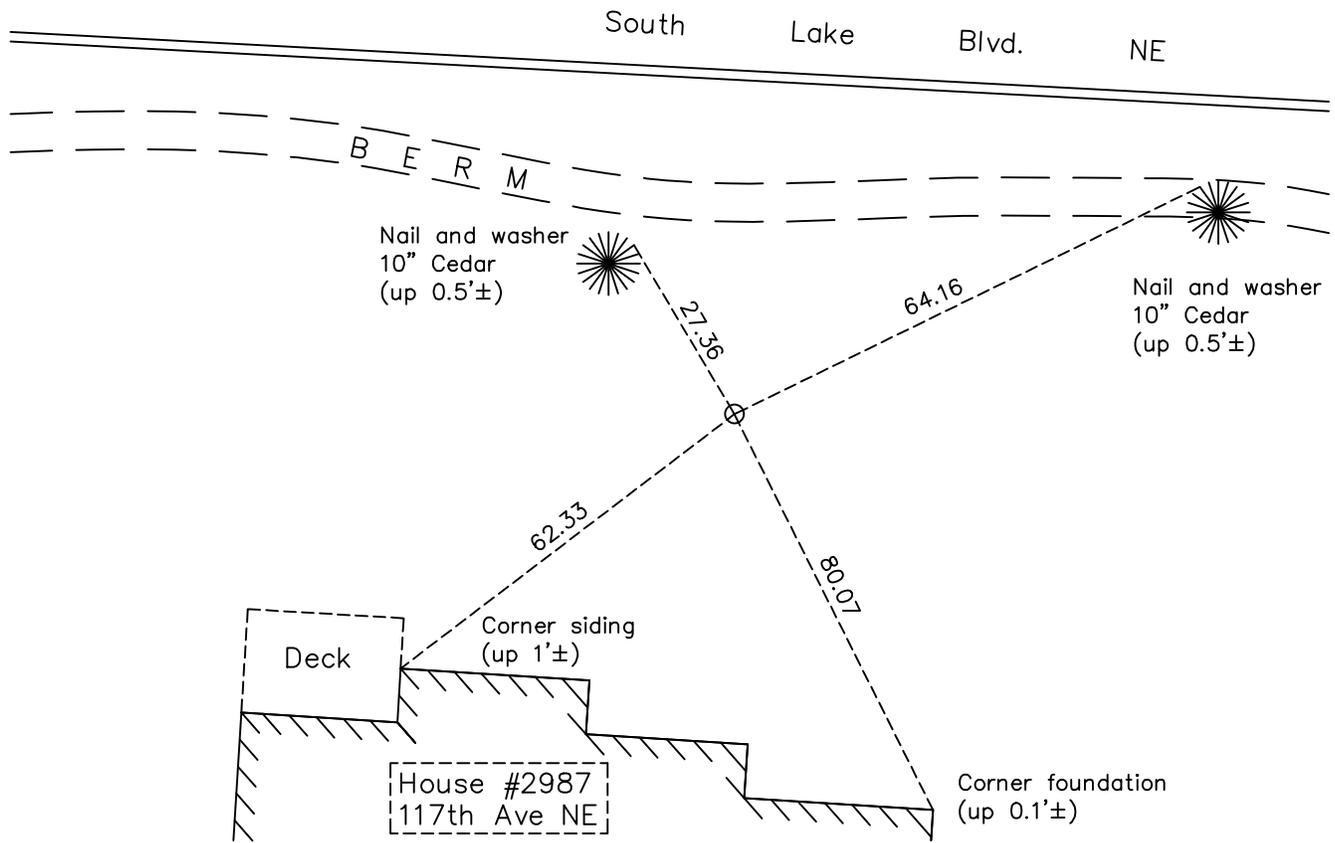

Revision Date  
 05/15/2025

N.A.D. 1983 Coordinates  
 (2011 Adjustment)

County Project Coordinates	
Northing	153661.5377
Easting	518735.8583
Date	05/08/2025

I hereby certify that this United States public land survey monument record is correct and complete to the best of my knowledge and belief.

*David Zieglermeier* Date 9/10/25

David M. Zieglermeier, Anoka County Surveyor  
 Minnesota License Number 46179

# HISTORY OF GOVERNMENT CORNER

County of Anoka

State of Minnesota

## North 1/4 Corner of Sec. 15 Township 31 Range 23

### **CORNER HISTORY:**

September 11, 1963 - Found 1" iron pipe up 1'± with the remains of 2 1/2" squared oak stake along west side of iron. No ties available.

September 16, 1963 - Found 1" iron pipe. Replaced with a new red and white 1" x 8' iron pipe up 4'±.

August 12, 1968 - Found 1" iron pipe badly bent to the NW about 1'±. Possible reset in the winter.

September 28, 1981 - Set cast iron monuments as witness corners 40.00 easterly and 20.00 southerly, both monuments down 1'± in field roads. No available ties.

6/3/86, 8/2/90, 7/24/95, 11/16/99 - Found witness corner cast iron monuments. No available ties.

February 10, 2000 - Found witness corner cast iron monument 40.00 easterly of North 1/4 corner Sec 15 T 31 R 23 and established NAD 1983 (1996 Adjustment) Anoka County Project Coordinates by Static GPS methods. Computed coordinates to North 1/4 Corner using witness corner coordinates.

N = 153660.8045	E = 518775.8620	(W.C. CIM)
N = 153661.5510	E = 518735.8690	(N 1/4 1" IP - Computed)

May 2, 2003 - THE LAKES OF RADISSON denotes found North 1/4 Corner Sec 15 T 31 R 23 to be existing.

April 18, 2005 - THE LAKES OF RADISSON EIGHTEENTH ADDITION denotes found North 1/4 Corner Sec 15 T 31 R 23 to be existing. Monument disturbed during development construction.

June 15, 2006 - Set Witness corner cast iron monument 345.00 westerly along section line using Static GPS method. Established NAD 1983 (1996 Adjustment) Anoka County Project Coordinates by Static GPS methods. Established ties to witness corner.

N = 153667.9783	E = 518390.9184	(W.C. CIM)
-----------------	-----------------	------------

May 15, 2014 - Found Witness corner cast iron monument without a top. Added a monument top to bring to flush. Verified position by VRS GPS method. Updated ties.

6/11/19, 5/2/22 - Found Witness corner cast iron monument flush. Verified position by VRS GPS method. Updated ties.

May 8, 2025 - Set a new 1/2" rebar with "County Surveyor" cap and punch mark down 0.1'± using Static GPS method. Verified position by RTK GPS method. Established ties. NAD 1983 (2011 adj)

N = 153661.5377	E = 518735.8583
-----------------	-----------------