

CERTIFICATE OF LOCATION OF GOVERNMENT CORNER

County of Anoka


State of Minnesota

CENTER Corner of Sec. 17 Township 31 Range 23

I hereby certify that on the 10 day of OCT., 1962, I found the described corner which was evidenced by SPIKE

and I further certify that to perpetuate the location of said corner, I did, at the exact location thereof, place a permanent marker consisting of _____

which reference or witness monuments are located in the manner following:

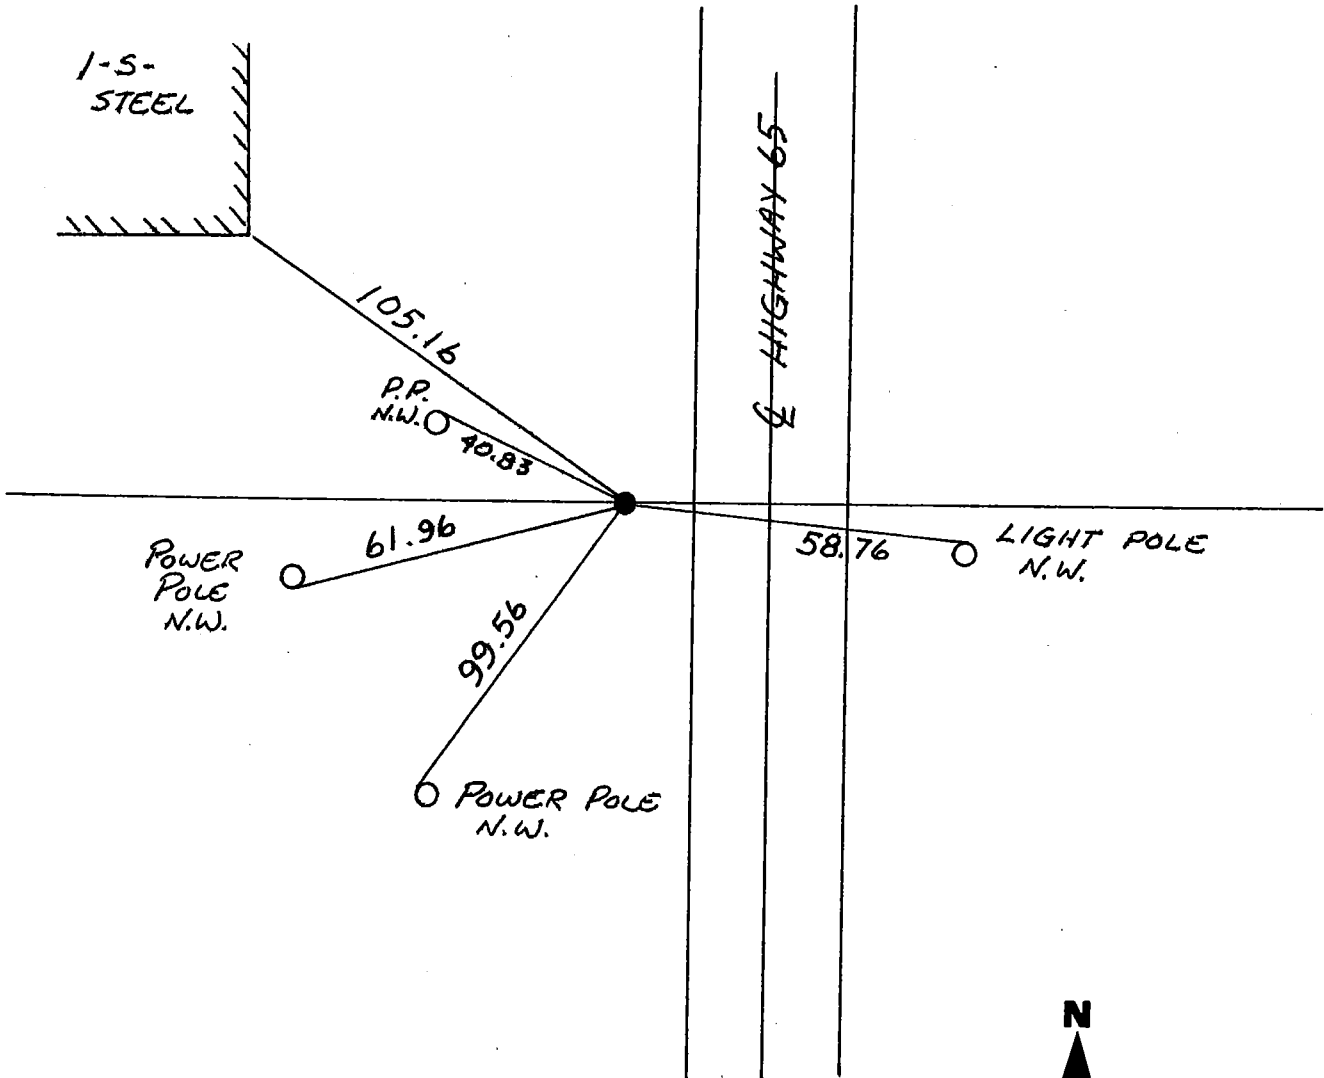

Revised date	Revised date	Revised date
7-11-90		
10-24-"		

