

# CERTIFICATE OF LOCATION OF GOVERNMENT CORNER

County of Anoka

State of Minnesota

CENTER Corner of Sec. 24 Township 31 Range 23


I hereby certify that on the 14<sup>TH</sup> day of SEPTEMBER 19 64, I found the described corner which was evidenced by 1/2" IRON PIPE NOTE : THIS LONG ESTABLISHED LOCATION

IS NOT THE TRUE NORTH - SOUTH AND EAST - WEST STRAIGHT LINE INTERSECTION !

and I further certify that to perpetuate the location of said corner, I did, at the exact location thereof, place a permanent marker consisting of 1/2" IRON PIPE

— FOR REFERENCE ONLY —

which reference or witness monuments are located in the manner following:

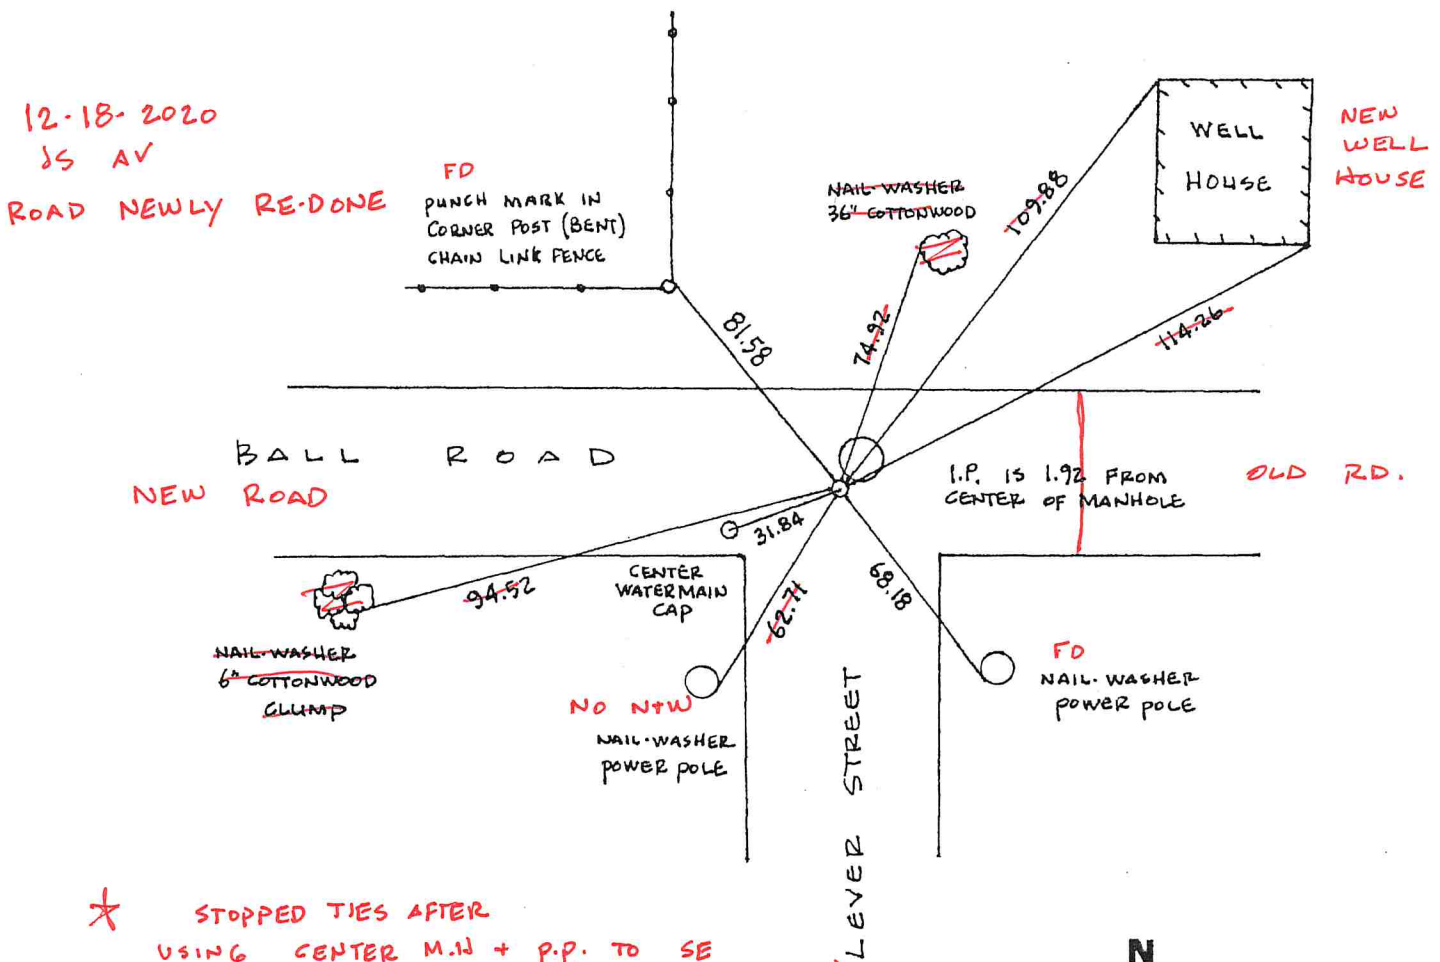

\* STOPPED TIES AFTER USING CENTER M.W + P.P. TO SE THE WATERMAIN CAP DOESN'T FIT (0.25 LONG)

Revised date	Revised date	Revised date
1-21-86		
6-3-86		
7-3-90		
12-3-98		

