

CERTIFICATE OF LOCATION OF GOVERNMENT CORNER

County of Anoka


State of Minnesota

CENTER Corner of Sec. 24 Township 31 Range 23

I hereby certify that on the 14TH day of SEPTEMBER, 19 64, I found the described corner which was evidenced by 1/2" IRON PIPE NOTE : THIS LONG ESTABLISHED LOCATION IS NOT THE TRUE NORTH - SOUTH AND EAST - WEST STRAIGHT LINE INTERSECTION !

and I further certify that to perpetuate the location of said corner, I did, at the exact location thereof, place a permanent marker consisting of 1/2" IRON PIPE
 — FOR REFERENCE ONLY —

which reference or witness monuments are located in the manner following:

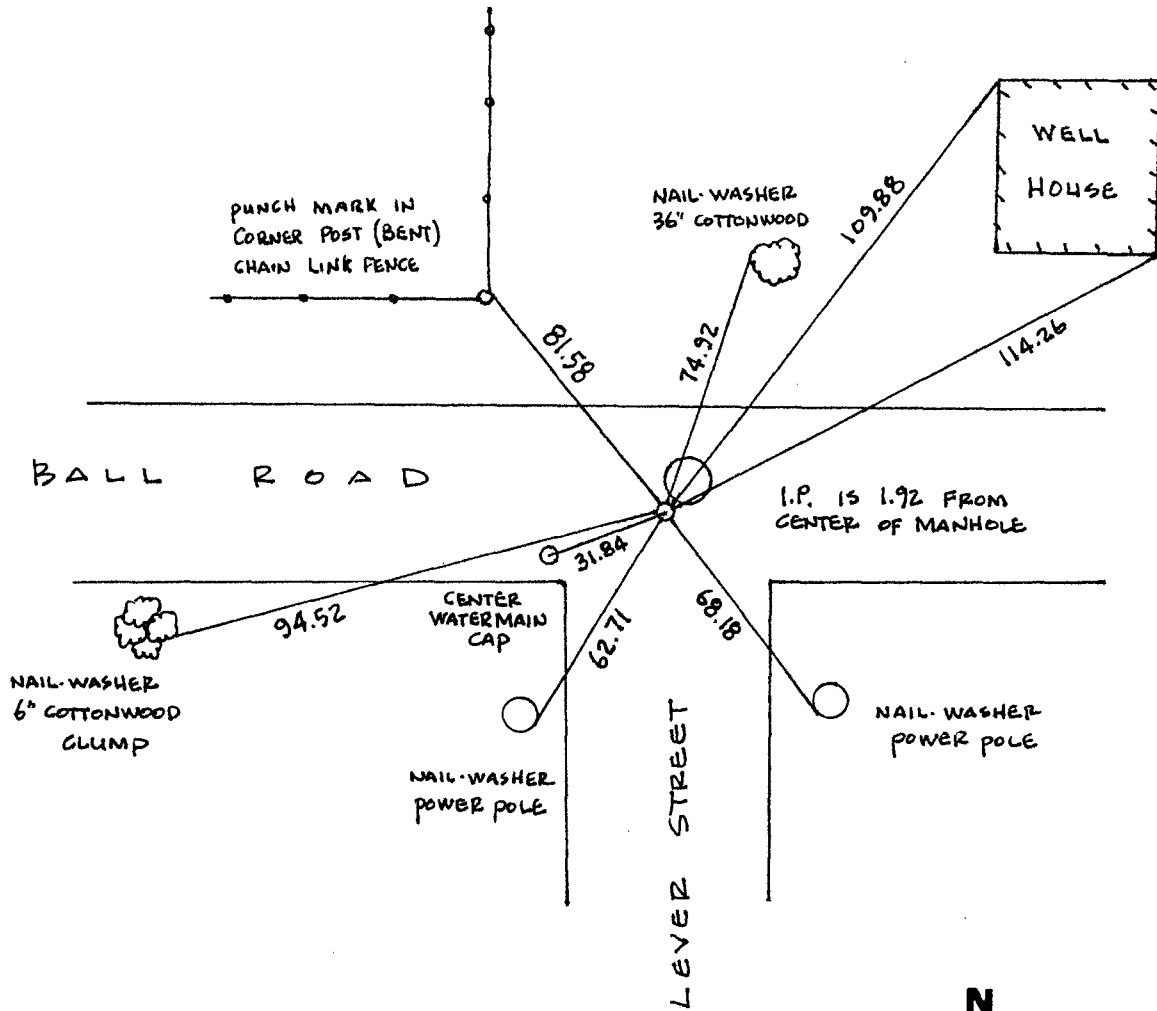

Revised date	Revised date	Revised date
1-21-86		
6-3-86		
7-3-90		
12-3-98		

