

# CERTIFICATE OF LOCATION OF GOVERNMENT CORNER

County of Anoka

State of Minnesota


## North $\frac{1}{4}$ Corner of Sec. 25 Township 31 Range 23

On the 19th day of July, 1968, the described corner was evidenced by an iron pipe

and to perpetuate the location of said corner, at the exact location thereof, a permanent marker was placed consisting of a cast iron monument

AND on the 13th day of May, 2022, said permanent marker was found flush and the ties were updated

Updated reference ties are as shown below.

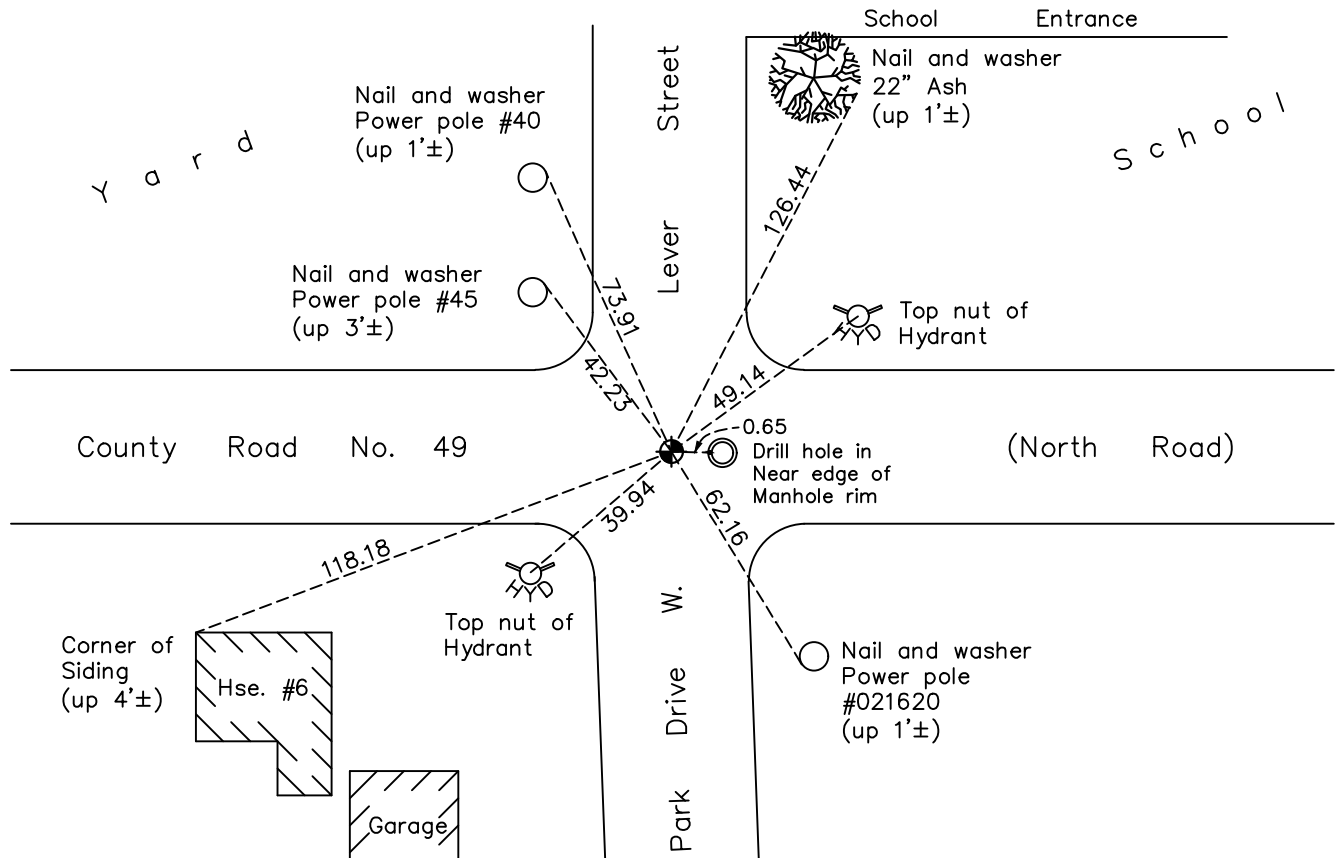

Revision Date  
08/12/22

N.A.D. 1983 Coordinates  
(1996 Adjustment)

County Project Coordinates	
Northing	142966.1873
Easting	529281.7057
Date	10/28/98

I hereby certify that this United States public land survey monument record is correct and complete to the best of my knowledge and belief.

*David Zieglmeier* Date 2/28/23

David Zieglmeier Anoka County Surveyor  
Minnesota License Number 46179

# HISTORY OF GOVERNMENT CORNER

Page No. 76

County of Anoka

State of Minnesota

## North 1/4 Corner of Sec. 25 Township 31 Range 23

### **CORNER HISTORY:**

August 10, 1956 - Documentation of Milner W. Carley ties of found Iron on unknown date.

June 19, 1959 - Found iron and added additional ties by Northern Natural Gas Company.

Unknown Date - Found iron and updated ties by Anoka County Highway Department.

March 8, 1962 - Found 1" iron pipe down 0.3' and updated ties.

June 10, 1964 - Found 1" iron pipe and updated ties.

July 19, 1968 - Found 1" iron pipe and replaced with a cast iron monument flush. Updated ties.

October 5, 1971 - Found cast iron monument and updated ties.

May 22, 1975 - Found cast iron monument and updated ties.

August 22, 1977 - Found cast iron monument and updated ties.

March 29, 1979 - Reset p.k. nail after construction.

November 1, 1979 - Found p.k. nail and replaced with a 1/2" iron pipe. Updated ties.

June 29, 1990 - Found 1/2" iron pipe and updated ties.

August 29, 1994 - Found 1/2" iron pipe and updated ties.

June 27, 1995 - Found 1/2" iron pipe and updated ties.

October 28, 1998 - Established NAD 1983 (1996 adj.) Anoka County project coordinates by static GPS methods.

November 2, 1998 - Found 1/2" iron pipe and updated ties.

June 22, 2006 - Found 1/2" iron pipe and updated ties.

July 7, 2014 - Found 1/2" iron pipe and replaced with a cast iron monument flush. Verified position by VRS GPS methods and updated ties.

June 20, 2019 - Found cast iron monument. Verified position by VRS GPS methods. Updated ties.

May 13, 2022 - Found cast iron monument flush. Verified position by VRS GPS methods. Updated ties.