

CERTIFICATE OF LOCATION OF GOVERNMENT CORNER

County of Anoka

State of Minnesota


South 1/4 Corner of Sec. 19 Township 31 Range 23

On the 23rd day of September, 1971, the described corner was evidenced by area resurvey

and to perpetuate the location of said corner, at the exact location thereof, a permanent marker was placed consisting of a cast iron monument with a sign and post on the north side

AND on the 25th day of January, 2023, said permanent marker was adjusted CIM due to found leaning condition from near fence post concrete setting. Ties were updated after adjustment.

Updated reference ties are as shown below.

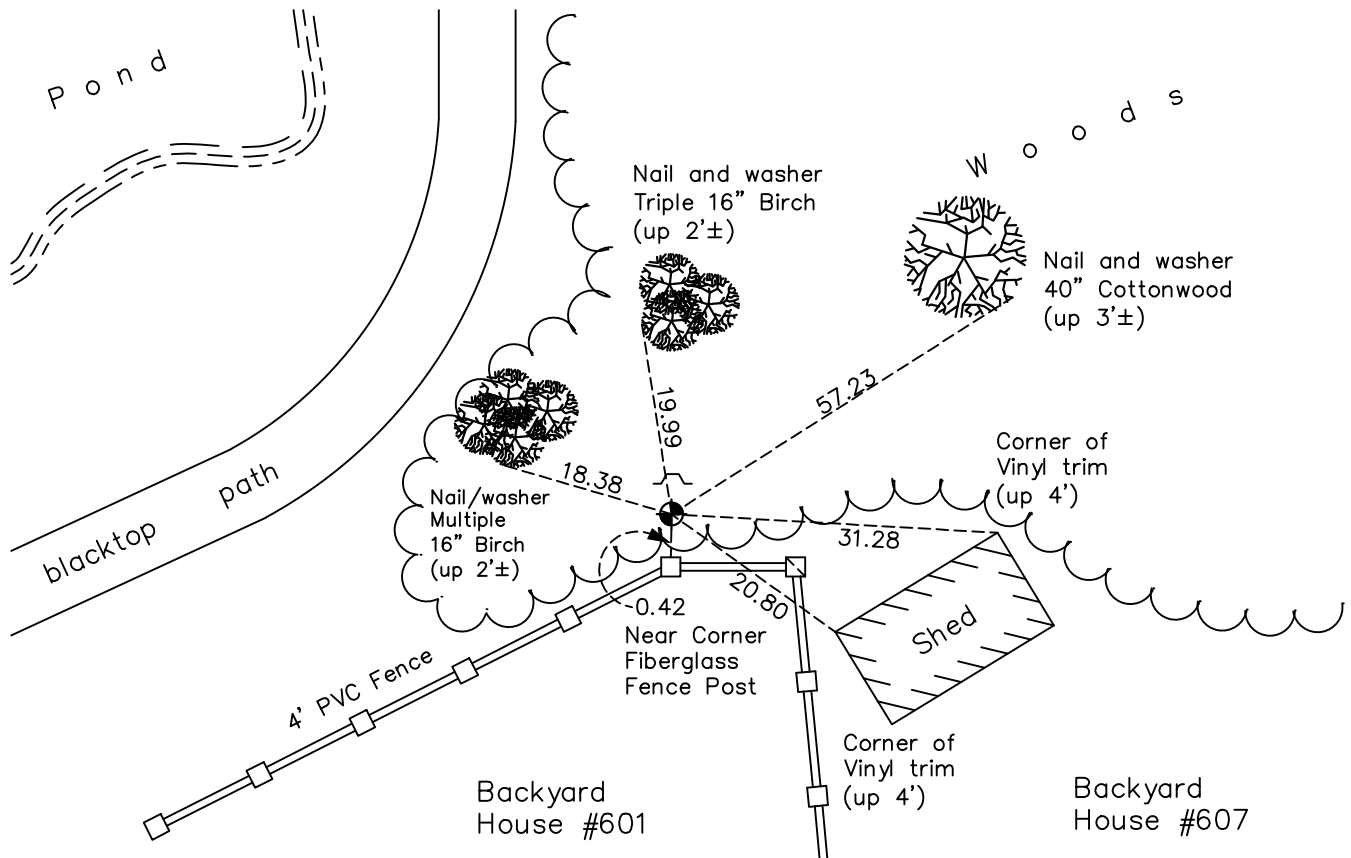

Revision Date

1/30/2023

N.A.D. 1983 Coordinates
(1996 Adjustment)

County Project Coordinates	
Northing	143139.5739
Easting	502760.4697
Date	12/10/98

I hereby certify that this United States public land survey monument record is correct and complete to the best of my knowledge and belief.

David Zieglmeier Date 2/28/23

David Zieglmeier Anoka County Surveyor
Minnesota License Number 46179

HISTORY OF GOVERNMENT CORNER

Page No. 86

County of Anoka

State of Minnesota

South 1/4 Corner of Sec. 19 Township 31 Range 23

CORNER HISTORY:

December 14, 1962 - Found a 3/4" pinched iron pipe and established ties to iron pipe.

August 9, 1968 - Found 3/4" pinched iron pipe and removed monument.

September 23, 1971 - Set cast iron monument flush using area resurvey and updated ties.

May 28, 1975 - Found cast iron monument and updated ties.

May 10, 1977 - Found cast iron monument and updated ties.

May 10, 1990 - Found cast iron monument down 0.5'± and leaning. Reset monument and updated ties.

July 30, 1990 - Found cast iron monument and updated ties.

October 21, 1991 - Found cast iron monument and updated ties.

June 26, 1995 - Found cast iron monument and updated ties.

July 5, 1995 - Found cast iron monument and updated ties.

November 6, 1998 - Found cast iron monument and updated ties.

December 10, 1998 - Established NAD 1983 (1996 adj.) Anoka County project coordinates by static GPS methods.

September 15, 2005 - Found cast iron monument down 1'± and updated ties.

June 9, 2014 - Found cast iron monument and updated ties.

June 19, 2019 - Found cast iron monument and updated ties.

May 10, 2022 - Found cast iron monument, verified position by VRS GPS method and updated ties

January 25, 2023 - Adjusted cast iron monument to original coordinates due to found leaning condition from near fence post concrete setting. Adjusted using County RTK GPS method and the ties were updated.