

CERTIFICATE OF LOCATION OF GOVERNMENT CORNER

County of Anoka

State of Minnesota


Southwest Corner of Sec. 25 Township 31 Range 23

On the 14th day of August, 1968, the described corner was evidenced by a concrete monument

and to perpetuate the location of said corner, at the exact location thereof, a permanent marker was placed consisting of a cast iron monument

AND on the 1st day of November, 2023, said permanent marker was reset 8" CIM after road const, set in concrete, using static GPS method. Updated ties and verified position w/ RTK GPS.

Updated reference ties are as shown below.

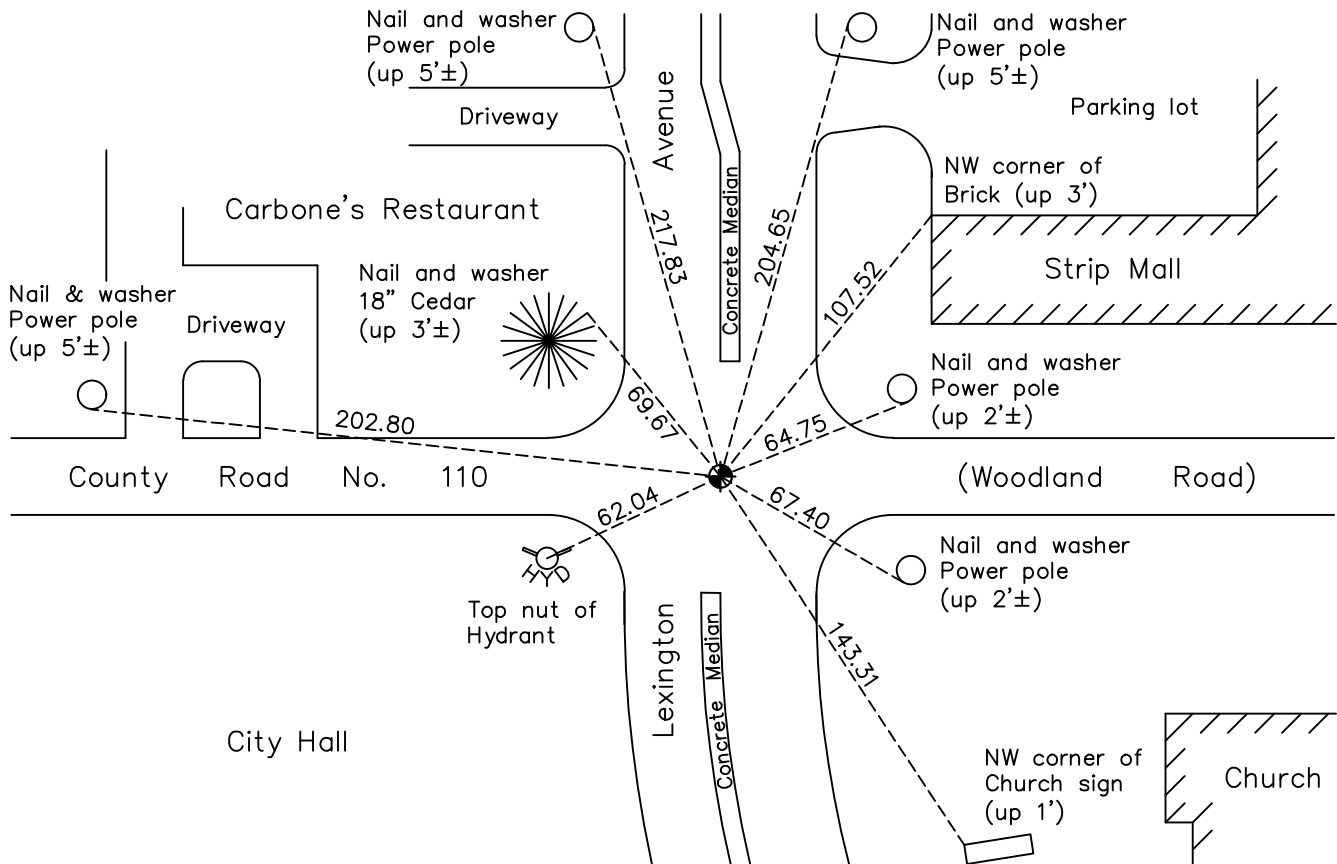

Revision Date
 11/06/2023

N.A.D. 1983 Coordinates
 (1996 Adjustment)

County Project Coordinates	
Northing	137772.9118
Easting	526577.9125
Date	10/19/98

I hereby certify that this United States public land survey monument record is correct and complete to the best of my knowledge and belief.
David Zieglmeier Date 12/7/23
 David Zieglmeier Anoka County Surveyor
 Minnesota License Number 46179

HISTORY OF GOVERNMENT CORNER

Page No. 97

County of Anoka

State of Minnesota

Southwest Corner of Sec. 25 Township 31 Range 23

CORNER HISTORY:

September 6, 1943 - Harvey Cartwright found a 1" x 4' iron down 6" and replaced it with a concrete monument down 8". Established ties to monument.

November 7, 1955 - Found concrete monument down 8" and updated ties by Charles O. Georgi.

December 1956 - Found iron pin and updated ties.

11/7/61, 6/10/64 - Found 4" concrete monument down 0.8' with a 1/2" iron pipe over top center. Updated ties.

August 14, 1968 - Found concrete monument missing due to road construction. Set cast iron monument flush after road construction and updated ties.

8/17/71, 5/22/75, 8/17/77, 6/2/86, 7/19/90, 6/26/95 - Found cast iron monument and updated ties.

October 19, 1998 - Found cast iron monument, established NAD 1983 (1996 adj.) Anoka County project coordinates by static GPS methods and updated ties.

May 5, 2001 - Found cast iron monument and set construction ties prior to construction. Removed monument.

6/5/02, 6/12/06, 6/26/14 - Found cast iron monument and updated ties.

6/28/19, 5/20/22 - Found cast iron monument, verified position by VRS GPS methods and updated ties.

April 14, 2023 - Loosened top and left in place for road construction. Then, fully removed August 17, 2023.

November 1, 2023 - Reset 8" Cast Iron Monument after road construction, set in concrete, using static GPS method. Updated ties after setting and verified position with RTK GPS method.