


CERTIFICATE OF LOCATION OF GOVERNMENT CORNER

SOUTH 1/16 County of Anoka State of Minnesota
OF THE *SOUTHWEST 1/4* Corner of Sec. 27 Township 31 Range 23

I hereby certify that on the 25 day of JULY, 1968, I found the described corner which was evidenced by A 1" IRON PIPE

and I further certify that to perpetuate the location of said corner, I did, at the exact location thereof, place a permanent marker consisting of A 1" IRON PIPE

which reference or witness monuments are located in the manner following:

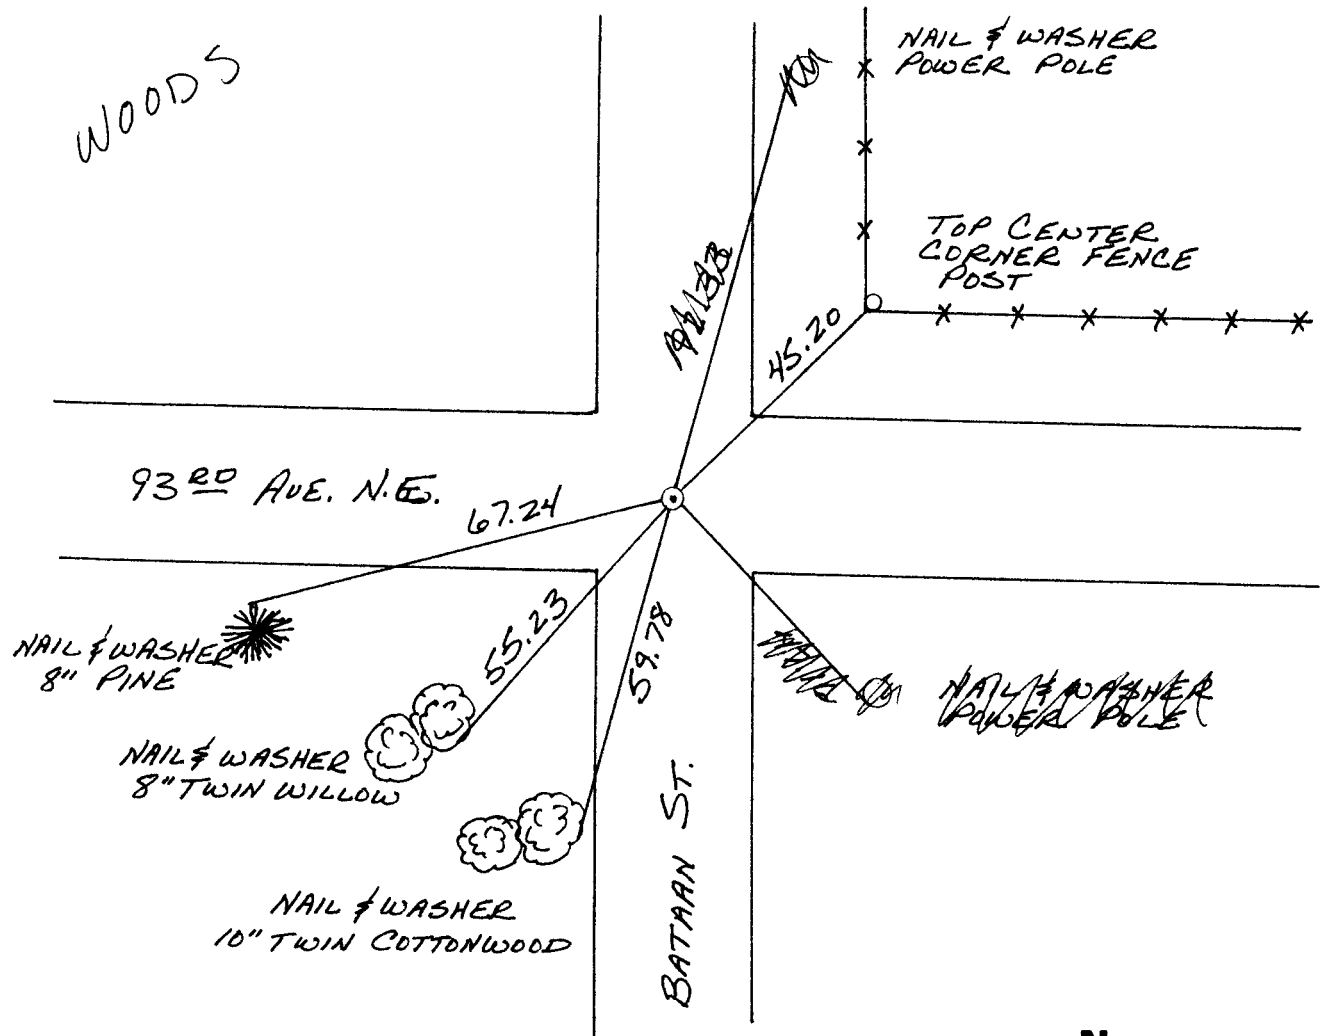

| Revised date | Revised date | Revised date |
|--------------|--------------|--------------|
| | | |
| | | |
| | | |
| | | |
| | | |
| | | |
| | | |
| | | |

