

# CERTIFICATE OF LOCATION OF GOVERNMENT CORNER

County of Anoka

State of Minnesota


## Southwest Corner of Sec. 27 Township 31 Range 23

On the 8th day of November, 1961, the described corner was evidenced by a 1/2" iron pipe

and to perpetuate the location of said corner, at the exact location thereof, a permanent marker was placed consisting of a cast iron monument

AND on the 10th day of May, 2022, said permanent marker was found flush and the ties were updated

Updated reference ties are as shown below.

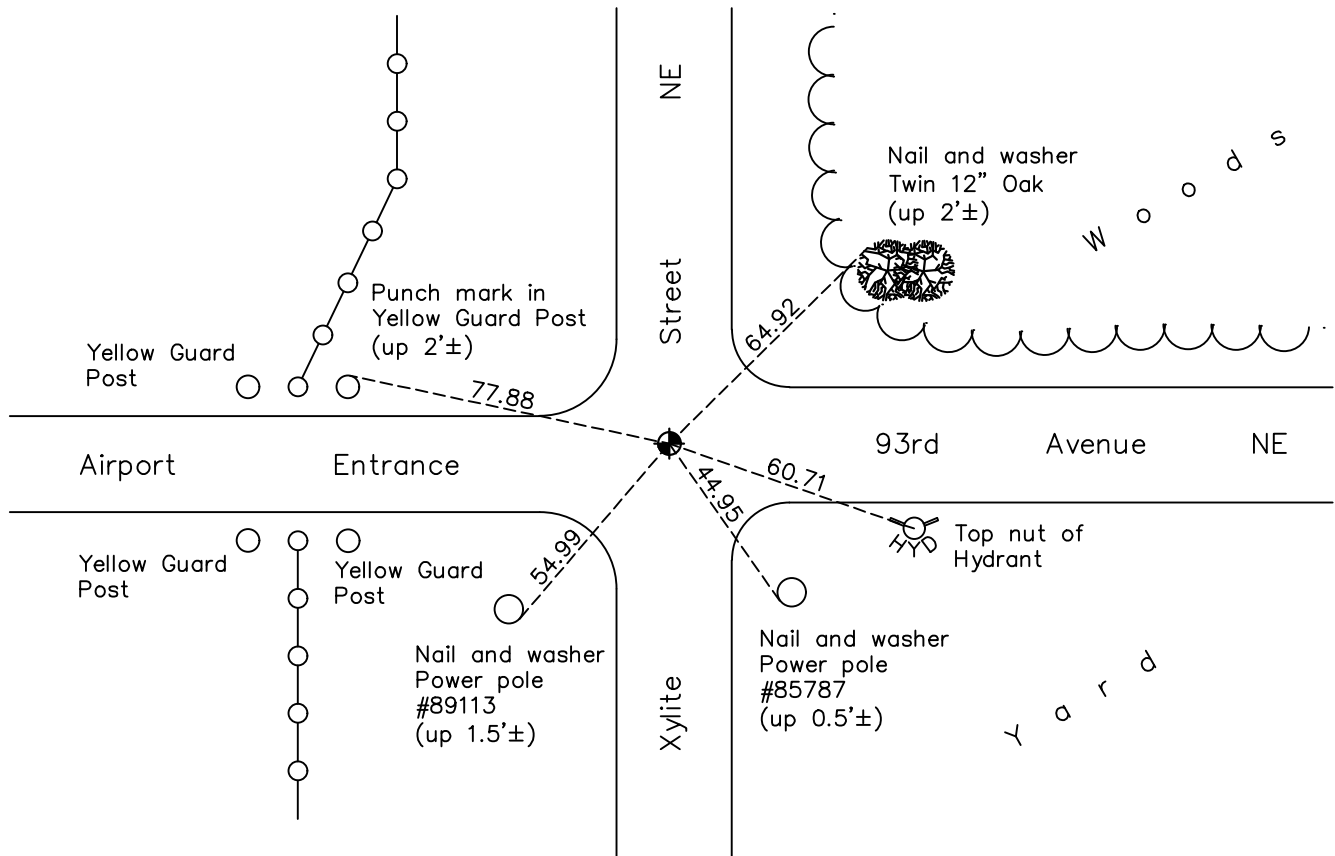

Revision Date  
 10/19/2022

N.A.D. 1983 Coordinates  
 (1996 Adjustment)

County Project Coordinates	
Northing	137827.5679
Easting	515996.7102
Date	7/08/99

I hereby certify that this United States public land survey monument record is correct and complete to the best of my knowledge and belief.  
*David Zieglmeier* Date 2/28/23  
 David Zieglmeier Anoka County Surveyor  
 Minnesota License Number 46179

# HISTORY OF GOVERNMENT CORNER

Page No. 102

County of Anoka

State of Minnesota

## Southwest Corner of Sec. 27 Township 31 Range 23

### **CORNER HISTORY:**

May 1925 - Found iron and established ties to iron by Egan, Field & Novak.

October 1960 - Found pinched iron pipe and updated ties by Suburban Engineering.

November 8, 1961 - Found 1/2" iron pipe down 1' using suburban engineering ties. Updated ties.

June 11, 1964 - Found iron flush and updated ties.

July 23, 1968 - Found iron and replaced with a cast iron monument flush. Updated ties.

September 24, 1971 - Found cast iron monument and updated ties.

May 21, 1975 - Found cast iron monument and updated ties.

August 17, 1977 - Found cast iron monument and updated ties.

June 1980 - Found cast iron monument and updated ties.

July 16, 1990 - Found cast iron monument and updated ties.

June 27, 1995 - Found cast iron monument and updated ties.

September 26, 1997 - Found cast iron monument, set construction ties and updated corner ties prior to road construction.

December 30, 1997 - Set P.K. nail after road construction.

May 19, 1998 - Found P.K. nail and replaced with a cast iron monument and updated ties.

July 8, 1999 - Found cast iron monument, established NAD 1983 (1996 adj.) Anoka County project coordinates by static GPS methods and updated ties.

June 15, 2006 - Found cast iron monument and updated ties.

June 20, 2014 - Found cast iron monument down and raised flush. Verified position by VRS GPS methods and updated ties.

June 24, 2019 - Found cast iron monument, verified position by VRS GPS methods and updated ties.

May 10, 2022 - Found cast iron monument flush, verified position by VRS GPS methods and updated ties.