

CERTIFICATE OF LOCATION OF GOVERNMENT CORNER

County of Anoka

State of Minnesota


Northwest Corner of Sec. 33 Township 31 Range 23

On the 13th day of August, 1968, the described corner was evidenced by an iron spike

and to perpetuate the location of said corner, at the exact location thereof, a permanent marker was placed consisting of a cast iron monument

AND on the 9th day of May, 2022, said permanent marker was found flush and the ties were updated

Updated reference ties are as shown below.

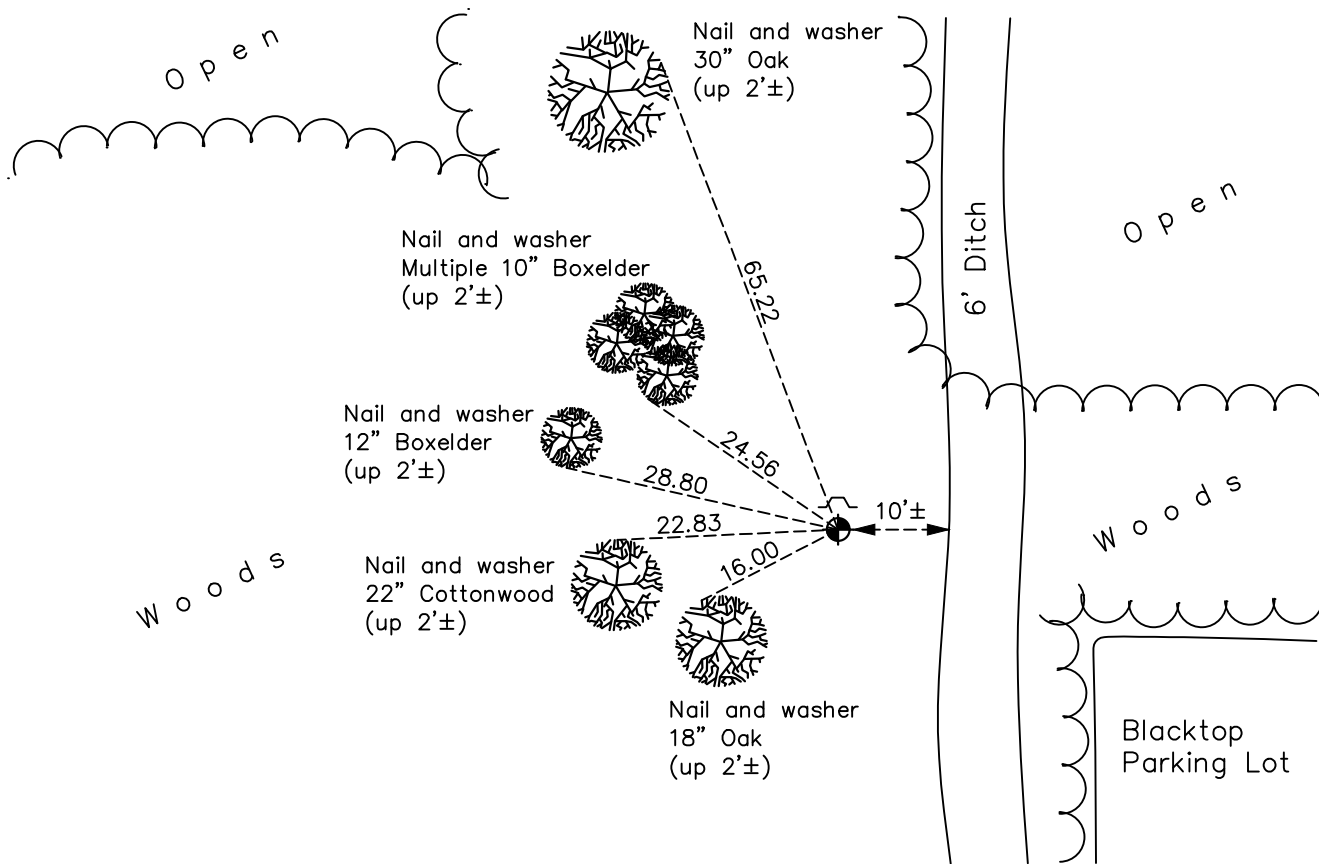

Revision Date
 10/19/2022

N.A.D. 1983 Coordinates
 (1996 Adjustment)

County Project Coordinates	
Northing	137847.6031
Easting	510701.9384
Date	7/08/99

I hereby certify that this United States public land survey monument record is correct and complete to the best of my knowledge and belief.
David Zieglmeier Date 2/28/23
 David Zieglmeier Anoka County Surveyor
 Minnesota License Number 46179

HISTORY OF GOVERNMENT CORNER

Page No. 104

County of Anoka

State of Minnesota

Northwest Corner of Sec. 33 Township 31 Range 23

CORNER HISTORY:

1958 - Found 1/2" iron pin and updated ties to iron pin by Minnesota Highway Department.

March 29, 1963 - Found 1/2" reinforcing rod using M.H.D. ties. Updated ties.

June 15, 1964 - Found 1/2" reinforcing rod and updated ties.

August 13, 1968 - Found iron rod and replaced with a cast iron monument up 0.1'±. Updated ties.

September 27, 1971 - Found cast iron monument and updated ties.

May 21, 1975 - Found cast iron monument and updated ties.

August 18, 1977 - Found cast iron monument and updated ties.

June 18, 1980 - Found cast iron monument and updated ties.

June 4, 1986 - Found cast iron monument and updated ties.

July 23, 1990 - Found cast iron monument with sign and post on the north side. Updated ties.

July 5, 1995 - Found cast iron monument and updated ties.

July 8, 1999 - Found cast iron monument, established NAD 1983 (1996 adj.) Anoka County project coordinates by static GPS methods and updated ties.

June 9, 2014 - Found cast iron monument and updated ties.

June 25, 2019 - Found cast iron monument and updated ties.

May 9, 2022 - Found cast iron monument flush, verified position by VRS GPS method and updated ties.