

CERTIFICATE OF LOCATION OF GOVERNMENT CORNER

County of Anoka

State of Minnesota


Northeast Corner of Sec. 31 Township 31 Range 23

On the 19th day of December, 1960, the described corner was evidenced by a concrete monument

and to perpetuate the location of said corner, at the exact location thereof, a permanent marker was placed consisting of a cast iron monument

AND on the 6th day of May, 2022, said permanent marker was found flush and the ties were updated

Updated reference ties are as shown below.

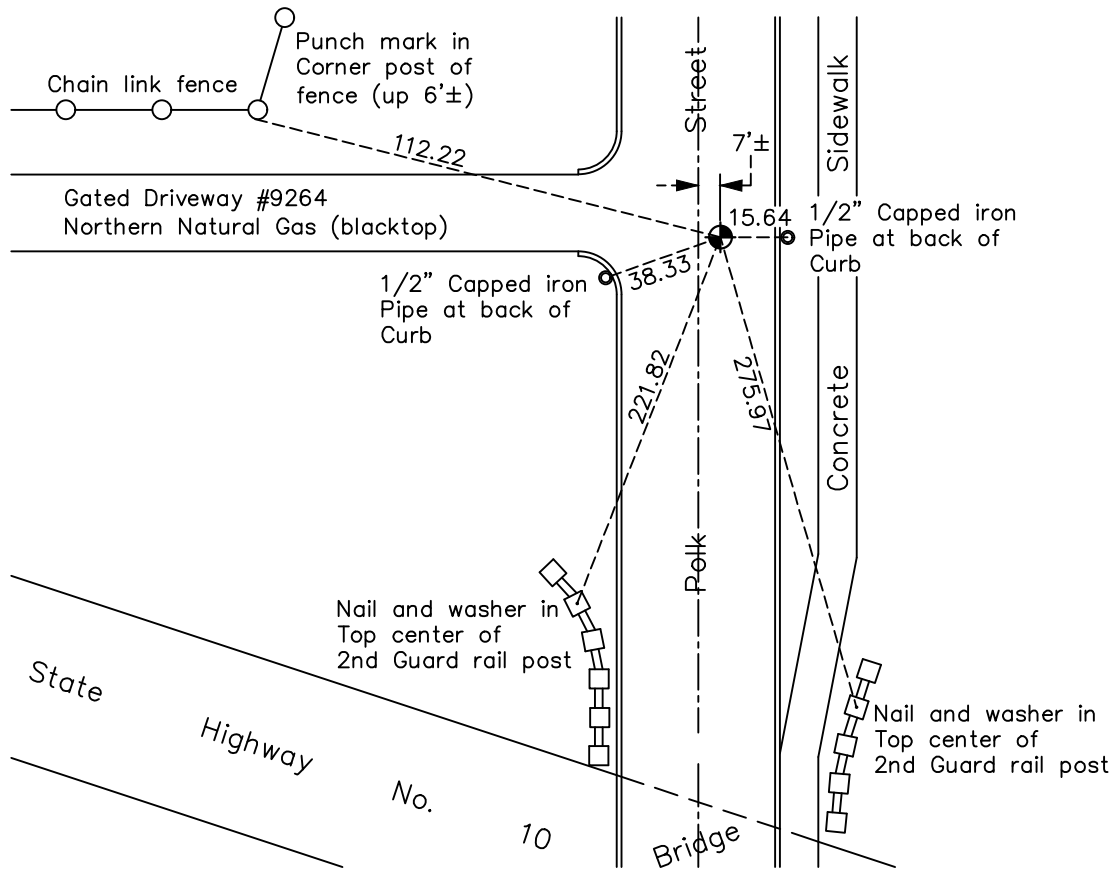

Revision Date
 10/19/2022

N.A.D. 1983 Coordinates
 (1996 Adjustment)

County Project Coordinates	
Northing	137863.0786
Easting	505410.1241
Date	7/08/99

I hereby certify that this United States public land survey monument record is correct and complete to the best of my knowledge and belief.
David Zieglmeier Date 2/28/23
 David Zieglmeier Anoka County Surveyor
 Minnesota License Number 46179

HISTORY OF GOVERNMENT CORNER

Page No. 106

County of Anoka

State of Minnesota

Northeast Corner of Sec. 31 Township 31 Range 23

CORNER HISTORY:

December 19, 1960 - Found concrete monument down 1.5' with top broken off and an iron on the north edge. Established ties to monument.

June 12, 1964 - Found broken concrete monument and placed a P.K. nail above concrete in blacktop road. Updated ties.

July 29, 1968 - Found P.K. nail and updated ties.

March 18, 1969 - Found P.K. nail and updated ties prior to sewer construction.

September 23, 1970 - Found P.K. nail and updated ties.

November 12, 1973 - Found broken concrete monument and replaced with a cast iron monument. Updated ties.

May 20, 1975 - Found cast iron monument and updated ties.

August 18, 1977 - Found cast iron monument and updated ties.

June 13, 1980 - Found cast iron monument and updated ties.

March 2, 1983 - Found cast iron monument and updated ties.

June 30, 1983 - Found cast iron monument and updated ties.

May 30, 1986 - Found cast iron monument and updated ties.

June 20, 1990 - Found cast iron monument and updated ties.

June 8, 1995 - Found cast iron monument and updated ties.

July 8, 1999 - Established NAD 1983 (1996 adj.) Anoka County project coordinates by static GPS methods.

July 21, 1999 - Reset Cast iron monument and updated ties.

August 2, 2006 - Found cast iron monument and updated ties.

June 18, 2014 - Found cast iron monument, verified position by VRS GPS methods and updated ties.

June 19, 2019 - Found cast iron monument, verified position by VRS GPS methods and updated ties.

May 6, 2022 - Found cast iron monument flush, verified position by VRS GPS methods and updated ties.