

CERTIFICATE OF LOCATION OF GOVERNMENT CORNER

County of Anoka


State of Minnesota

CENTER Corner of Sec. 31 Township 31 Range 23

I hereby certify that on the ___ day of _____, 19___, I found the described corner which was evidenced by _____

and I further certify that to perpetuate the location of said corner, I did, at the exact location thereof, place a permanent marker consisting of A 3/4" IRON PIPE

which reference or witness monuments are located in the manner following:

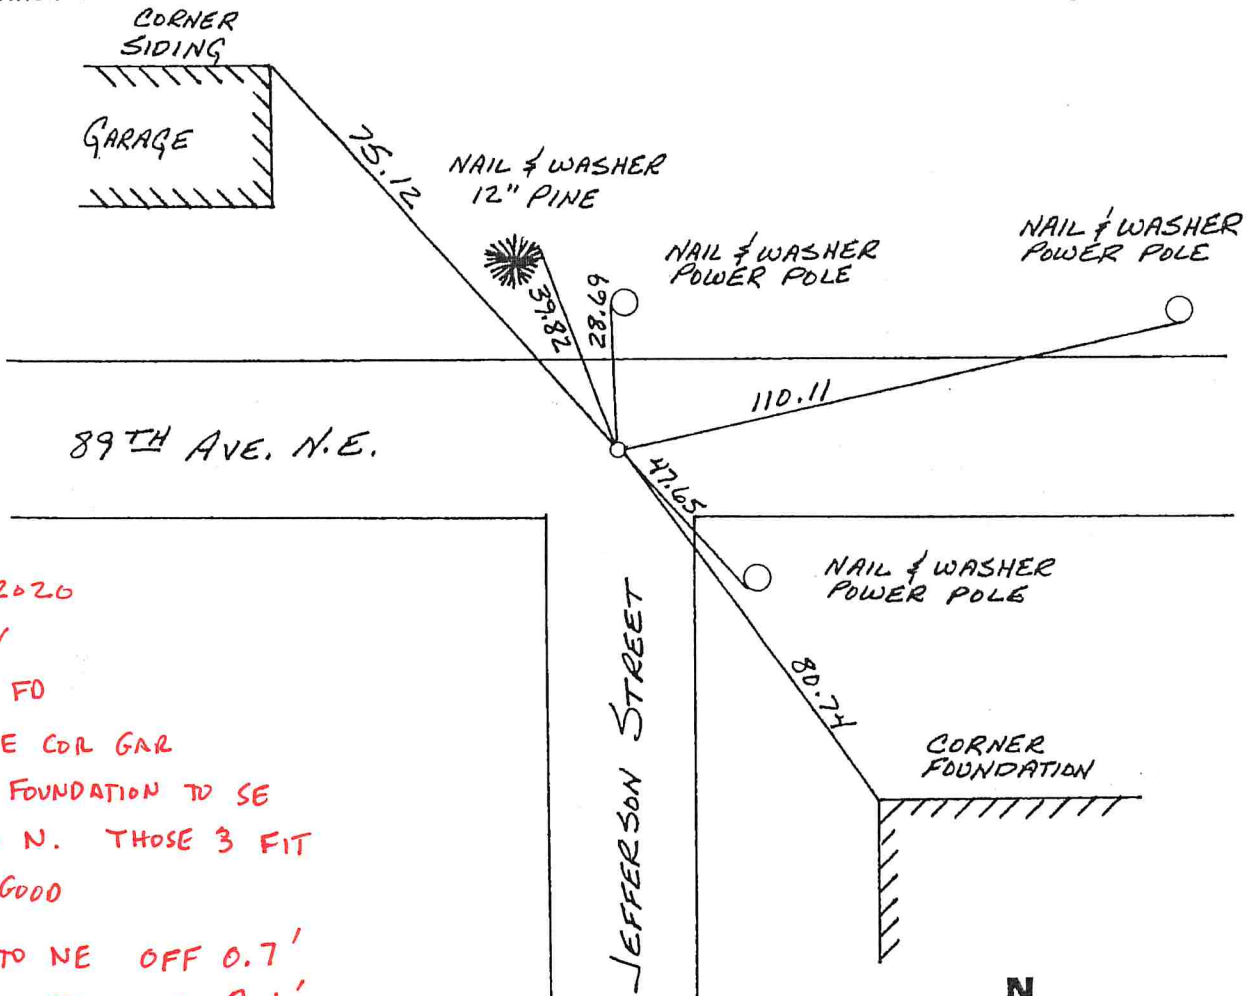

12-21-2020
 JS AV
 NO MON FO
 TIED IN NE COR GAR
 WITH COR FOUNDATION TO SE
 + p.p. TO N. THOSE 3 FIT
 PRETTY GOOD
 BUT pp. TO NE OFF 0.7'
 + pp. TO SE OFF 2.1'

Revised date	Revised date	Revised date
5-30-86		
6-20-90		

