

CERTIFICATE OF LOCATION OF GOVERNMENT CORNER

County of Anoka


State of Minnesota

CENTER Corner of Sec. 31 Township 31 Range 23

I hereby certify that on the _____ day of _____, 19____, I found the described corner which was evidenced by _____

and I further certify that to perpetuate the location of said corner, I did, at the exact location thereof, place a permanent marker consisting of A 3/4" IRON PIPE

which reference or witness monuments are located in the manner following:

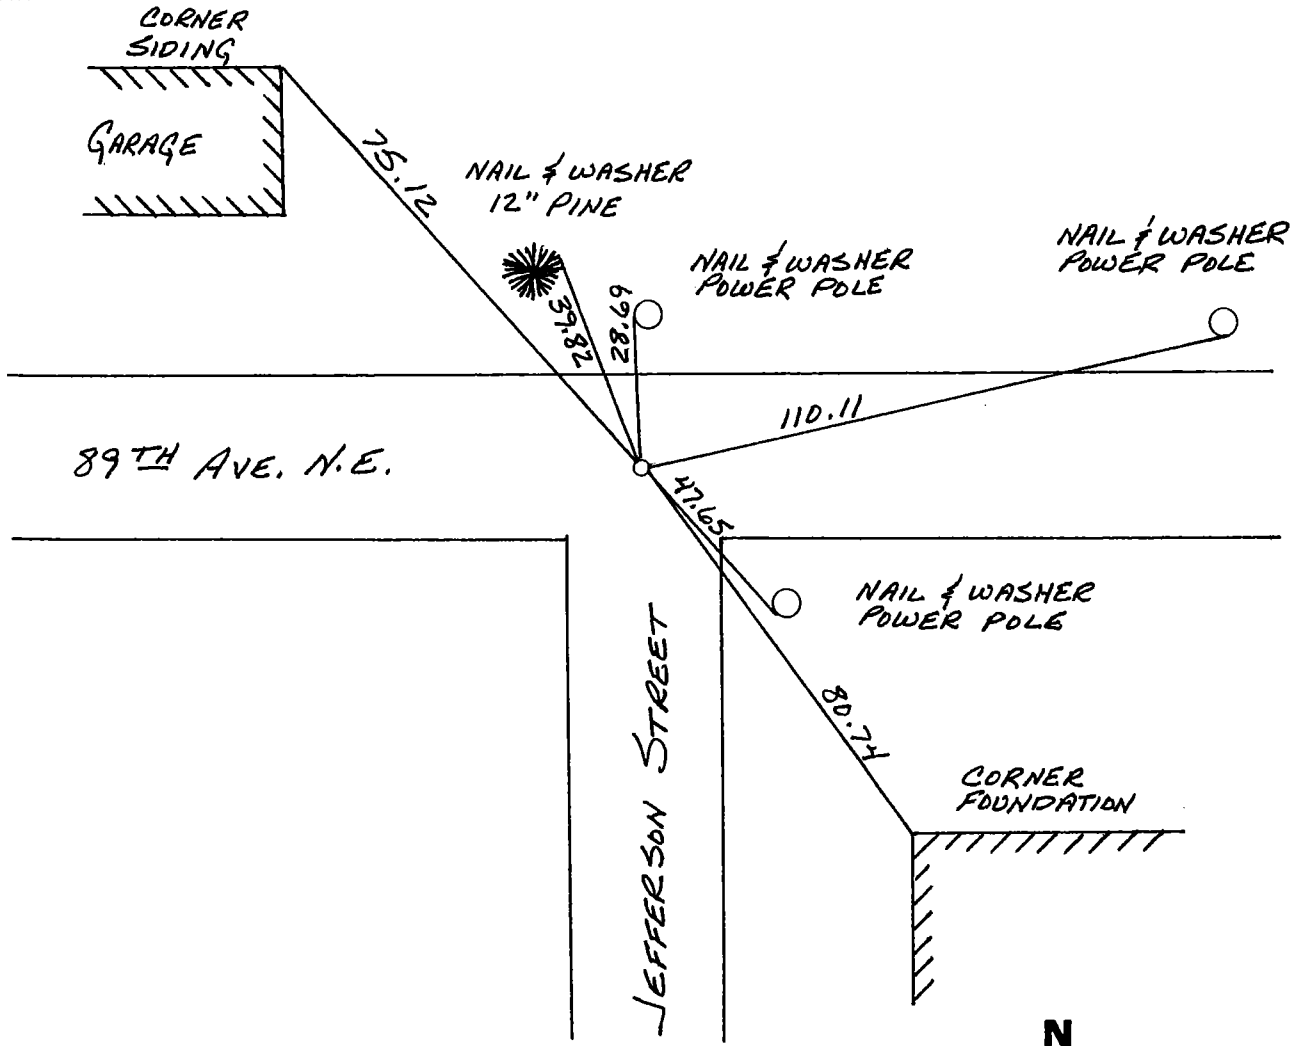

Revised date	Revised date	Revised date
5-30-86		
6-20-90		

