

CERTIFICATE OF LOCATION OF GOVERNMENT CORNER

County of Anoka


State of Minnesota

CENTER Corner of Sec. 34 Township 31 Range 23

I hereby certify that on the JUNE day of 1962, I found the described corner which was evidenced by _____

and I further certify that to perpetuate the location of said corner, I did, at the exact location thereof, place a permanent marker consisting of CAST IRON MONUMENT

which reference or witness monuments are located in the manner following:

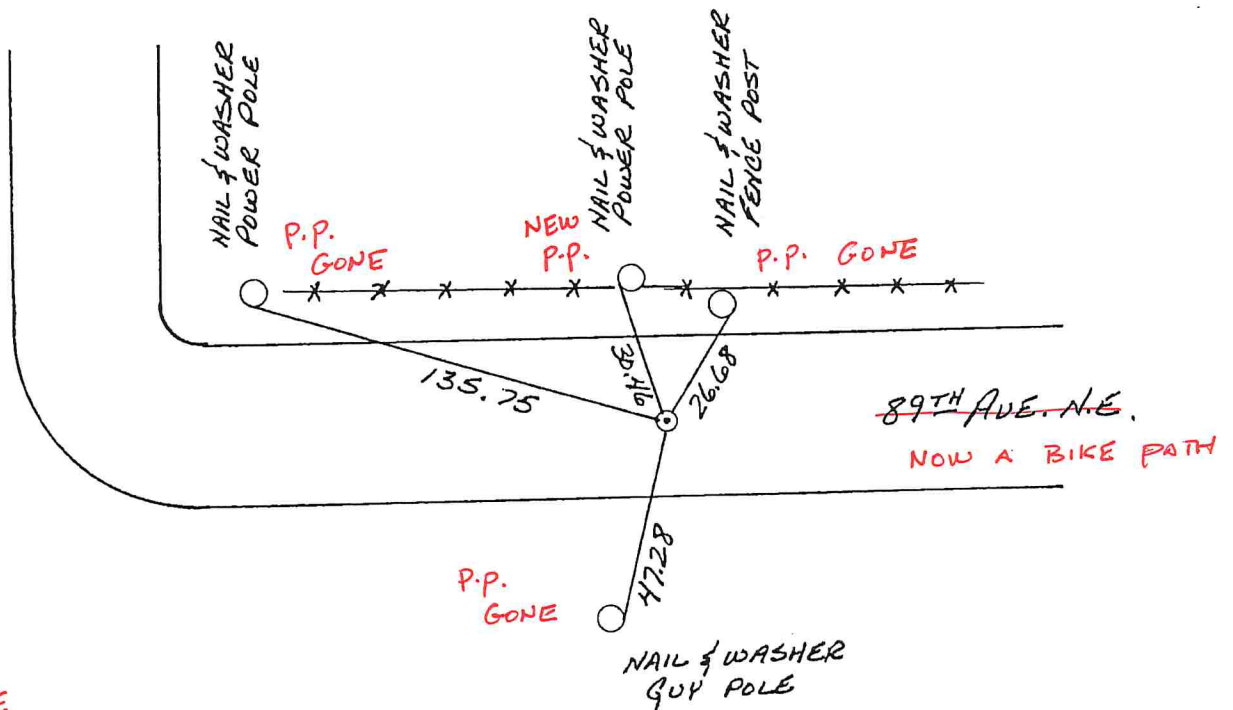

12-21-2020
JS AV
MON IS GONE

Revised date	Revised date	Revised date
6-9-86		
6-22-90		

