

# CERTIFICATE OF LOCATION OF GOVERNMENT CORNER

County of Anoka


State of Minnesota

CENTER Corner of Sec. 35 Township 31 Range 23

I hereby certify that on the      day of MAY, 1956, I found the described corner which was evidenced by A 2" IRON PIPE

and I further certify that to perpetuate the location of said corner, I did, at the exact location thereof, place a permanent marker consisting of A 1/2" IRON PIPE

which reference or witness monuments are located in the manner following:

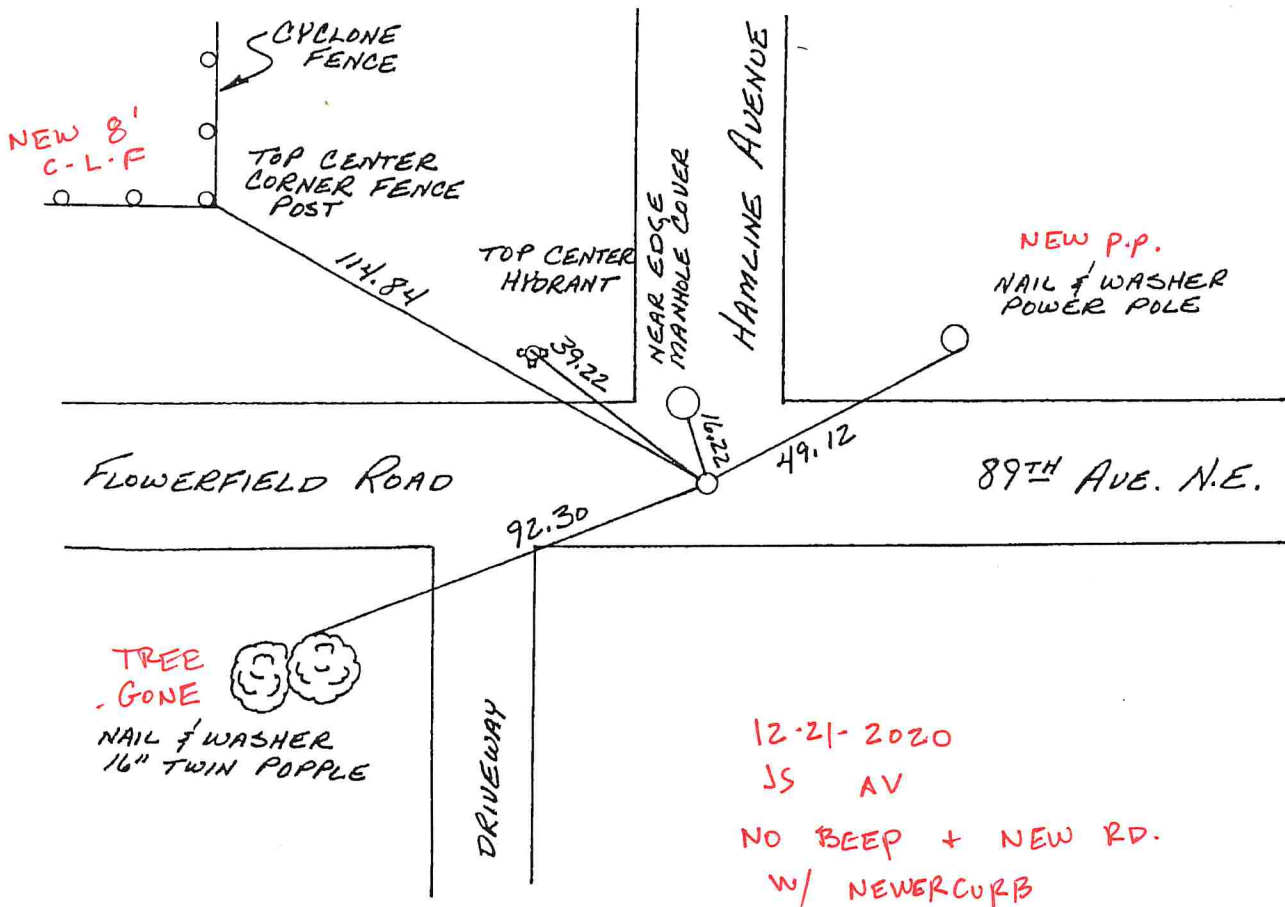

12-21-2020  
JS AV  
NO BEEP + NEW RD.  
W/ NEW CURB

Revised date	Revised date	Revised date
5-21-75		
4-30-86		
6-3-86		
6-21-90		

