

CERTIFICATE OF LOCATION OF GOVERNMENT CORNER

County of Anoka

State of Minnesota


Southwest Corner of Sec. 36 Township 31 Range 23

On the 11th day of July, 1963, the described corner was evidenced by area resurvey

and to perpetuate the location of said corner, at the exact location thereof, a permanent marker was placed consisting of a 1/2" iron pipe in concrete apron

AND on the 20th day of May, 2022, said permanent marker was found flush and the ties were updated

Updated reference ties are as shown below.

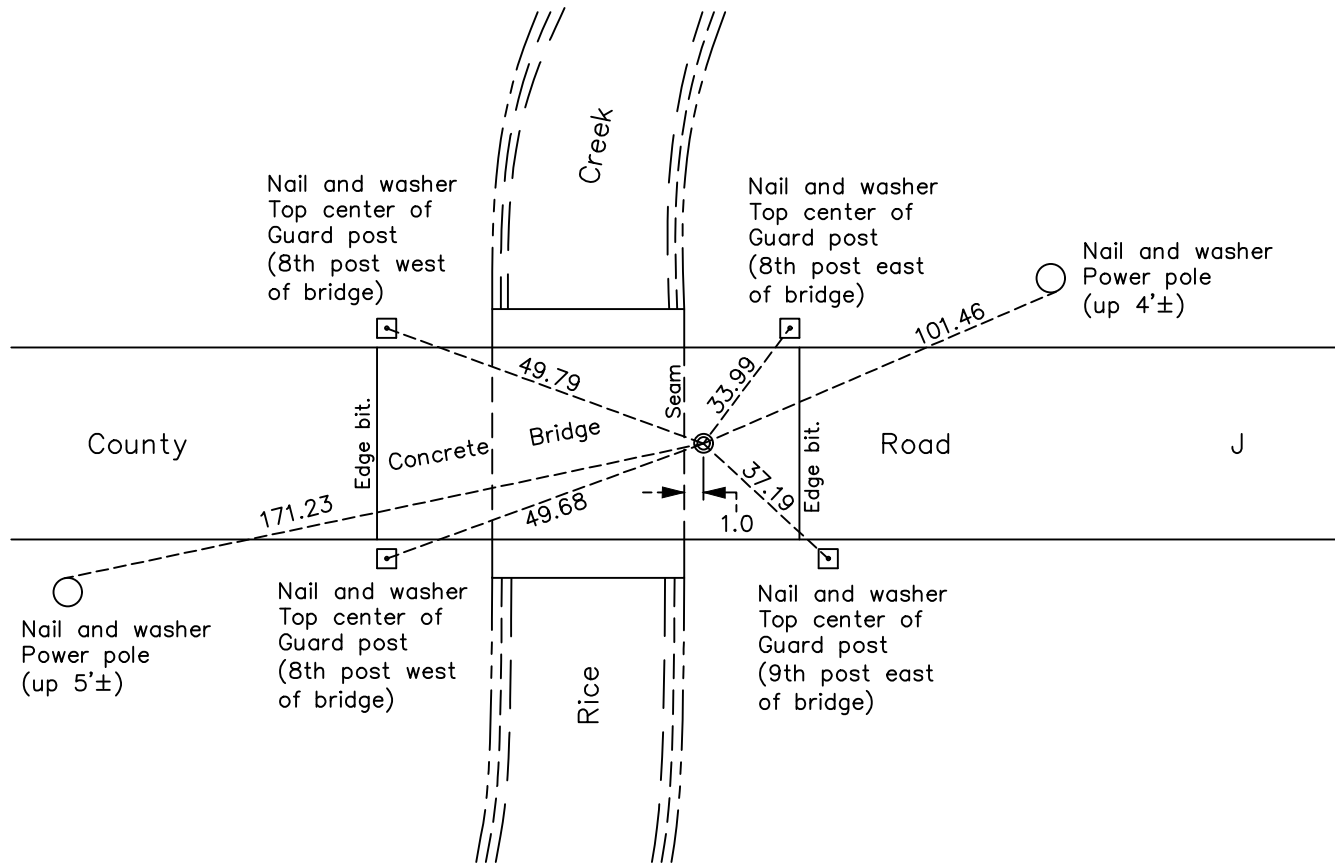

Revision Date
 10/20/2022

N.A.D. 1983 Coordinates
 (1996 Adjustment)

County Project Coordinates	
Northing	132465.2105
Easting	526558.3358
Date	10/19/98

I hereby certify that this United States public land survey monument record is correct and complete to the best of my knowledge and belief.

David Zieglmeier Date 2/28/23

David Zieglmeier Anoka County Surveyor
 Minnesota License Number 46179

HISTORY OF GOVERNMENT CORNER

Page No. 121

County of Anoka

State of Minnesota

Southwest Corner of Sec. 36 Township 31 Range 23

CORNER HISTORY:

July 11, 1963 - Set 3/4" iron pipe flush with blacktop road using area resurvey. Established ties to iron pipe.

June 10, 1964 - Found 3/4" iron pipe and updated ties.

December 16, 1970 - Set cast iron monument using old distances East and West and line to the North. Updated ties.

October 5, 1971 - Found cast iron monument and updated ties.

May 27, 1975 - Found cast iron monument and updated ties.

August 12, 1977 - Found cast iron monument and updated ties.

August 2, 1979 - Found cast iron monument down, raised flush and updated ties.

June 10, 1980 - Found cast iron monument and updated ties.

June 2, 1986 - Found cast iron monument and updated ties.

July 25, 1990 - Found cast iron monument and updated ties.

July 13, 1992 - Found cast iron monument and set construction ties prior to road construction.

August 17, 1993 - Found 1/2" iron pipe in concrete bridge apron after construction and updated ties.

June 7, 1995 - Found 1/2" iron pipe in concrete bridge apron and updated ties.

October 19, 1998 - Found 1/2" iron pipe in concrete bridge apron, established NAD 1983 (1996 adj.) Anoka County project coordinates by static GPS methods and updated ties.

June 12, 2006 - Found 1/2" iron pipe in concrete bridge apron and updated ties.

July 16, 2014 - Found 1/2" iron pipe in concrete bridge. Verified position by VRS GPS methods. Updated ties.

June 26, 2019 - Found 1/2" iron pipe in concrete bridge. Verified position by VRS GPS methods. Updated ties.

May 20, 2022 - Found 1/2" iron pipe in concrete bridge. Verified position by VRS GPS methods. Updated ties.