

CERTIFICATE OF LOCATION OF GOVERNMENT CORNER

County of Anoka

State of Minnesota


South 1/4 Corner of Sec. 35 Township 31 Range 23

On the 12th day of June, 1964, the described corner was evidenced by a 3/4" iron pipe

and to perpetuate the location of said corner, at the exact location thereof, a permanent marker was placed consisting of a cast iron monument

AND on the 11th day of May, 2022, said permanent marker was found and the ties were updated

Updated reference ties are as shown below.

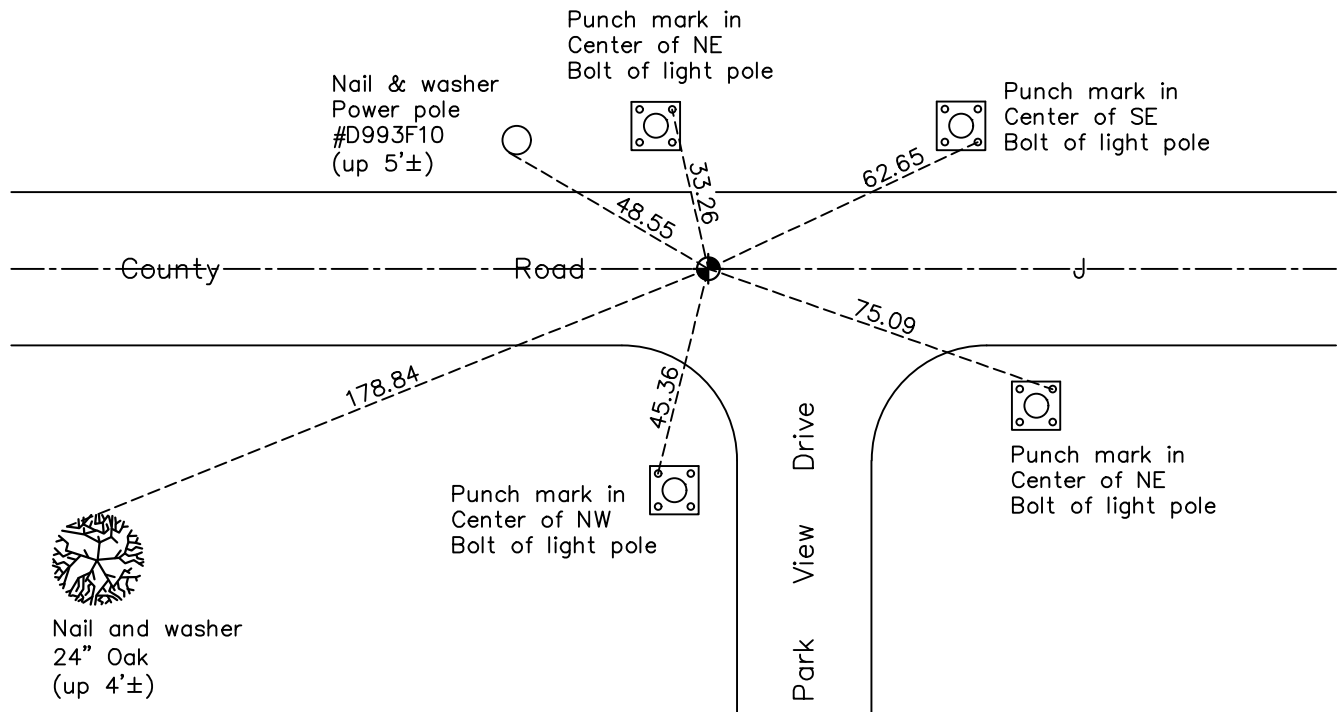

Revision Date
10/20/2022

N.A.D. 1983 Coordinates
(1996 Adjustment)

County Project Coordinates	
Northing	132479.6944
Easting	523926.5960
Date	7/27/99

I hereby certify that this United States public land survey monument record is correct and complete to the best of my knowledge and belief.

David Zieglmeier Date 2/28/23

David Zieglmeier Anoka County Surveyor
Minnesota License Number 46179

HISTORY OF GOVERNMENT CORNER

Page No. 123

County of Anoka

State of Minnesota

South 1/4 Corner of Sec. 35 Township 31 Range 23

CORNER HISTORY:

June 12, 1964 - Found 3/4" iron pipe flush set by Carley Engineering. Updated ties.

July 31, 1968 - Found 3/4" iron pipe down 0.1'± and a 4" x 4" concrete monument down 1.3'±. Set cast iron monument flush on top of concrete monument and updated ties.

October 1, 1971 - Found cast iron monument and updated ties.

May 27, 1975 - Found cast iron monument and updated ties.

August 12, 1977 - Found cast iron monument and updated ties.

June 11, 1980 - Found cast iron monument and updated ties.

June 2, 1986 - Found cast iron monument and updated ties.

October 1, 1987 - Found cast iron monument. Set construction ties prior to construction. Removed monument.

July 25, 1988 - Set cast iron monument after road construction.

August 1, 1990 - Found cast iron monument and updated ties.

June 27, 1995 - Found cast iron monument and updated ties.

July 27, 1999 - Found cast iron monument, established NAD 1983 (1996 adj.) Anoka County project coordinates by static GPS methods and updated ties.

June 14, 2006 - Found cast iron monument and updated ties.

July 16, 2014 - Found cast iron monument, verified position by VRS GPS methods and updated ties.

July 3, 2019 - Found cast iron monument and updated ties.

May 11, 2022 - Found cast iron monument flush, verified position by VRS GPS method and updated ties.