


Center Sec 32, T 31, R 23
Spike

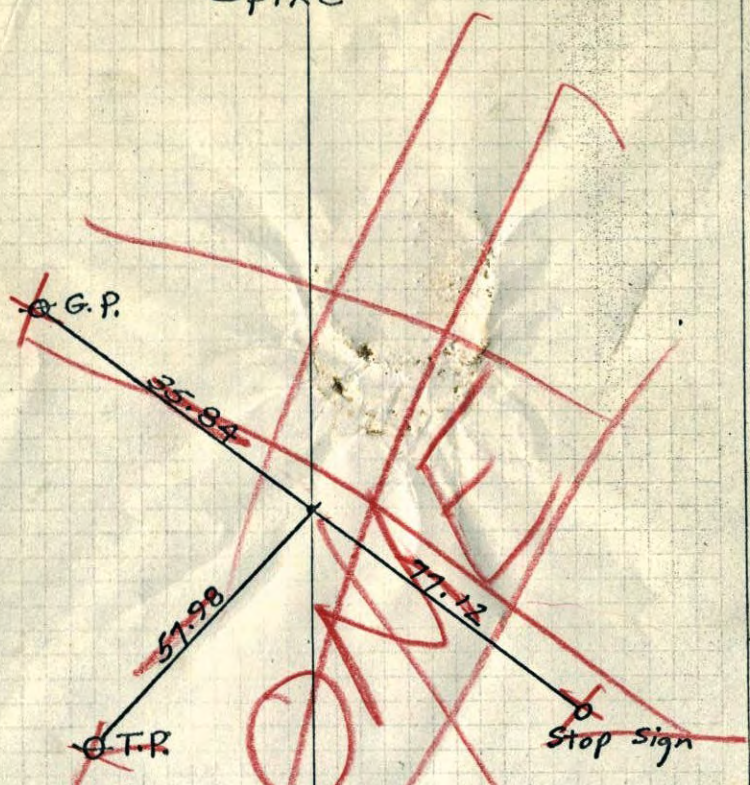


~~CO~~

8/28/69

Taken out
of book
July 1957
Carley

Center Sec 32, T 31, R 23
Spike

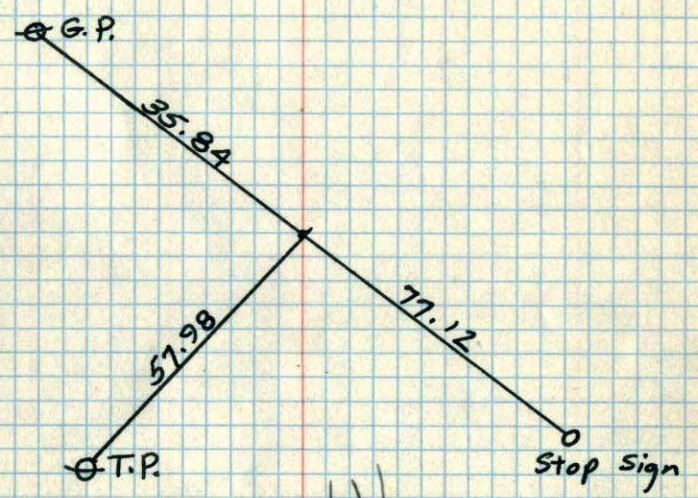


Cor. and All
Ties Gone
Apr. 69

July 1957
Carley

Dead file

73

Center Sec 32, T 31, R 23
Spike

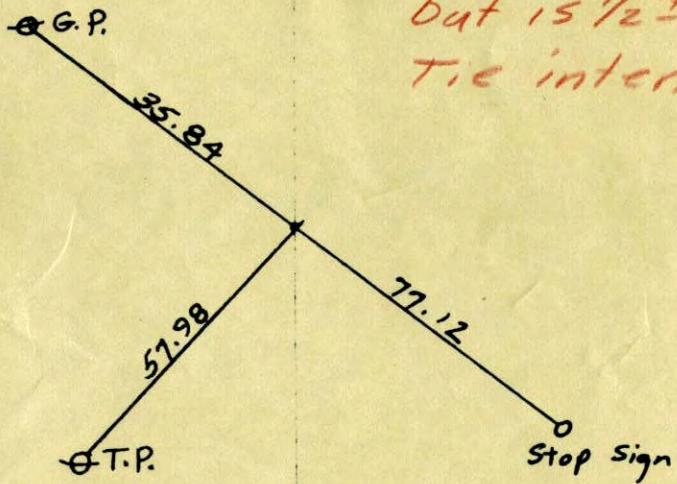


*Found a spike
but is 1/2" from
Tie inter.*

July 1957
Carley

Center Sec 32, T 31, R 23

G.P.

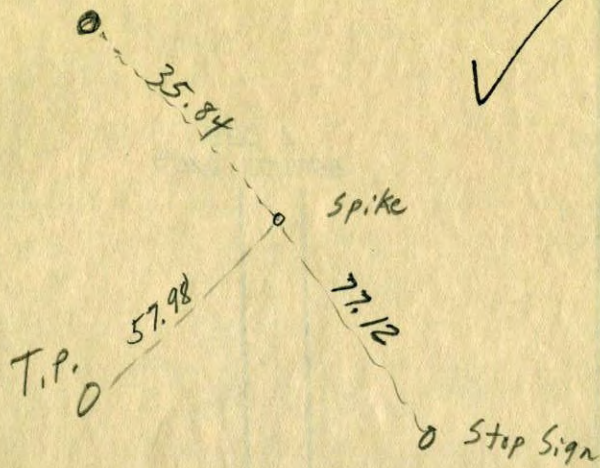

July 1957
Carley