


E 1/4 Cor. Sec. 9, T. 31, R. 23

Set 1 1/2" x 9' Iron pipe in ditch. Top 4' of pipe  
sticking up and painted with alternate 6"  
Red & White Bands. Can't take ties until winter.

Check in  
winter  
8/12/68

checked  
1-15-74  
H. Larson

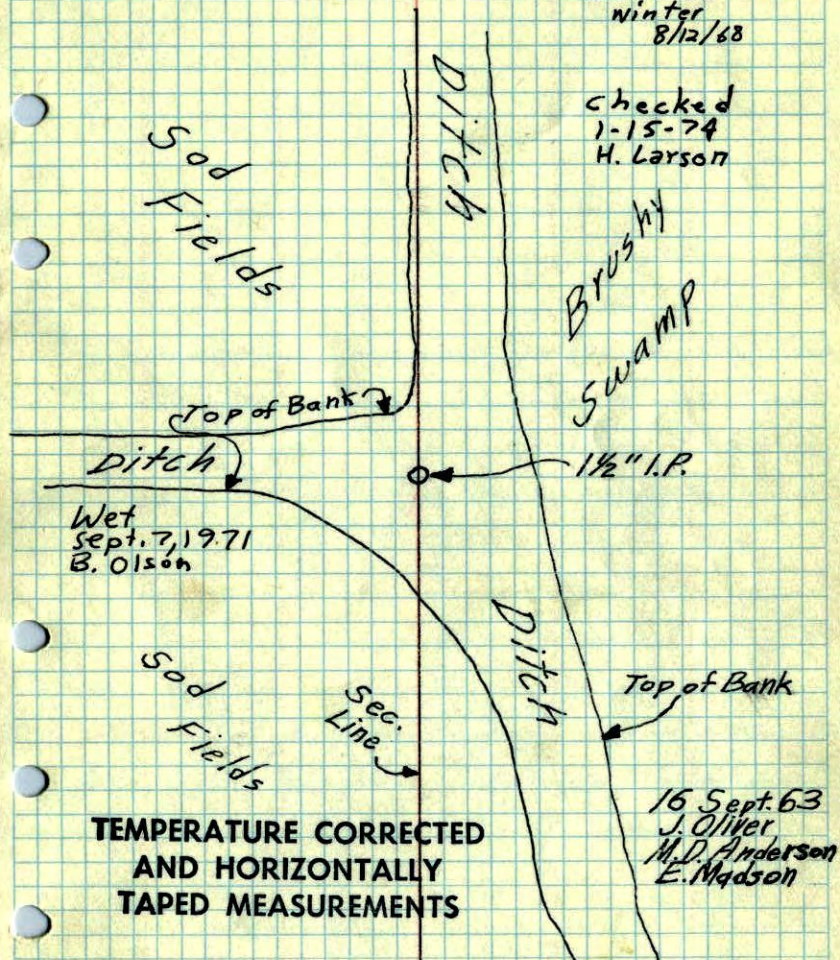

Wet  
sept. 7, 1971  
B. Olson

16 Sept. 63  
J. Oliver  
M.D. Anderson  
E. Madson


ROLAND W. ANDERSON  
COUNTY SURVEYOR  
ANOKA COUNTY, MINNESOTA

E 1/4 Cor. Sec. 9, T. 31, R. 23

Set 1 1/2" x 9' Iron Pipe in ditch. Top 4'  
of pipe sticking up and painted with  
alternate 6" Red and White Bands.  
Can't take ties until winter.

N 16 Sept 63

J. Oliver  
M.D. Anderson  
E. Madson

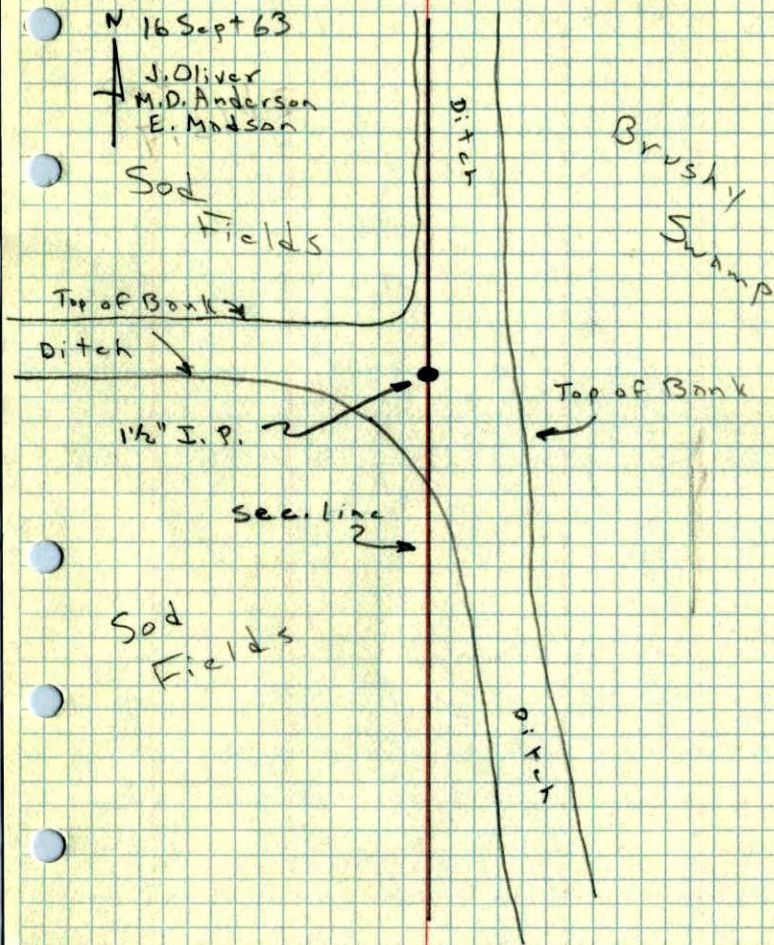

Sod  
Fields

Sod  
Fields