



W 1/4 Cor. Sec. 11, T31, R23

Found 4" Sq. Conc. Man. in middle of ditch under 4" of water. - Will have to take good ties in winter.

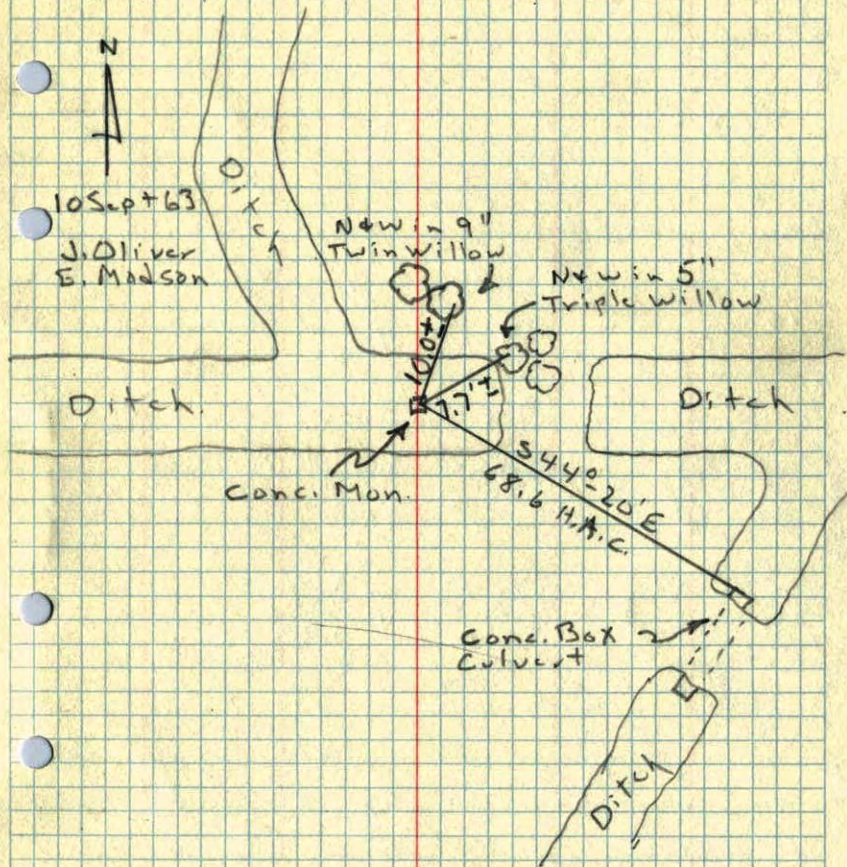

W 1/4 cor. of Sec. 11 T31 R23  
Conc. Man. up 1.0

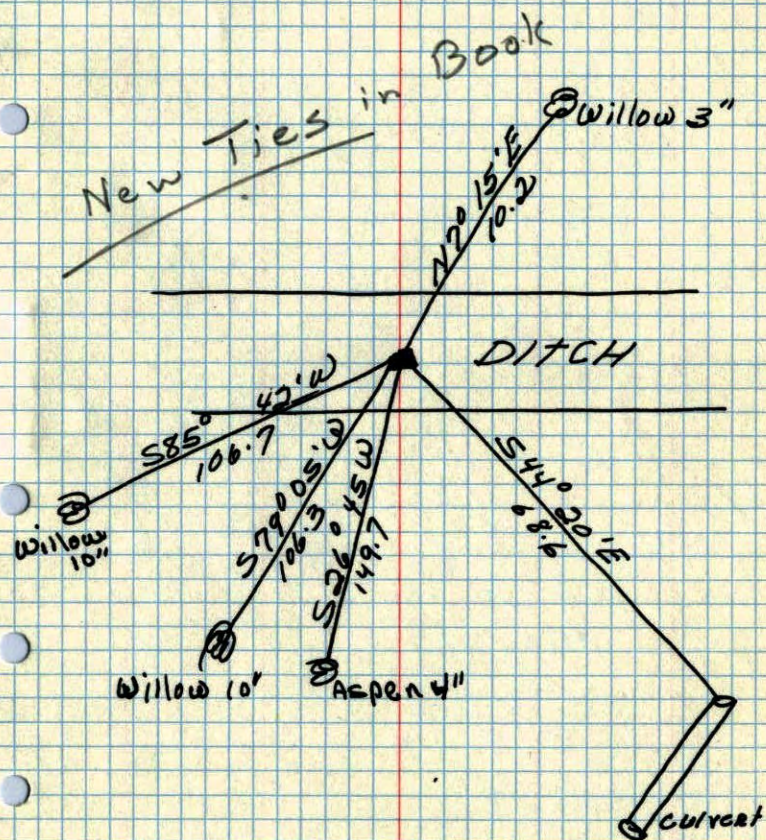

Nov. 23, 1948  
Cartwright