

CERTIFICATE OF LOCATION OF GOVERNMENT CORNER

County of Anoka

State of Minnesota


Northeast Corner of Sec. 2 Township 32 Range 22

On the ____ day of May, 1965, the described corner was evidenced by a 1" iron pipe found by Don Hult

and to perpetuate the location of said corner, at the exact location thereof, a permanent marker was placed consisting of a cast iron monument

AND on the 26th day of May, 2022, said permanent marker was found flush and the ties were updated.

Updated reference ties are as shown below.

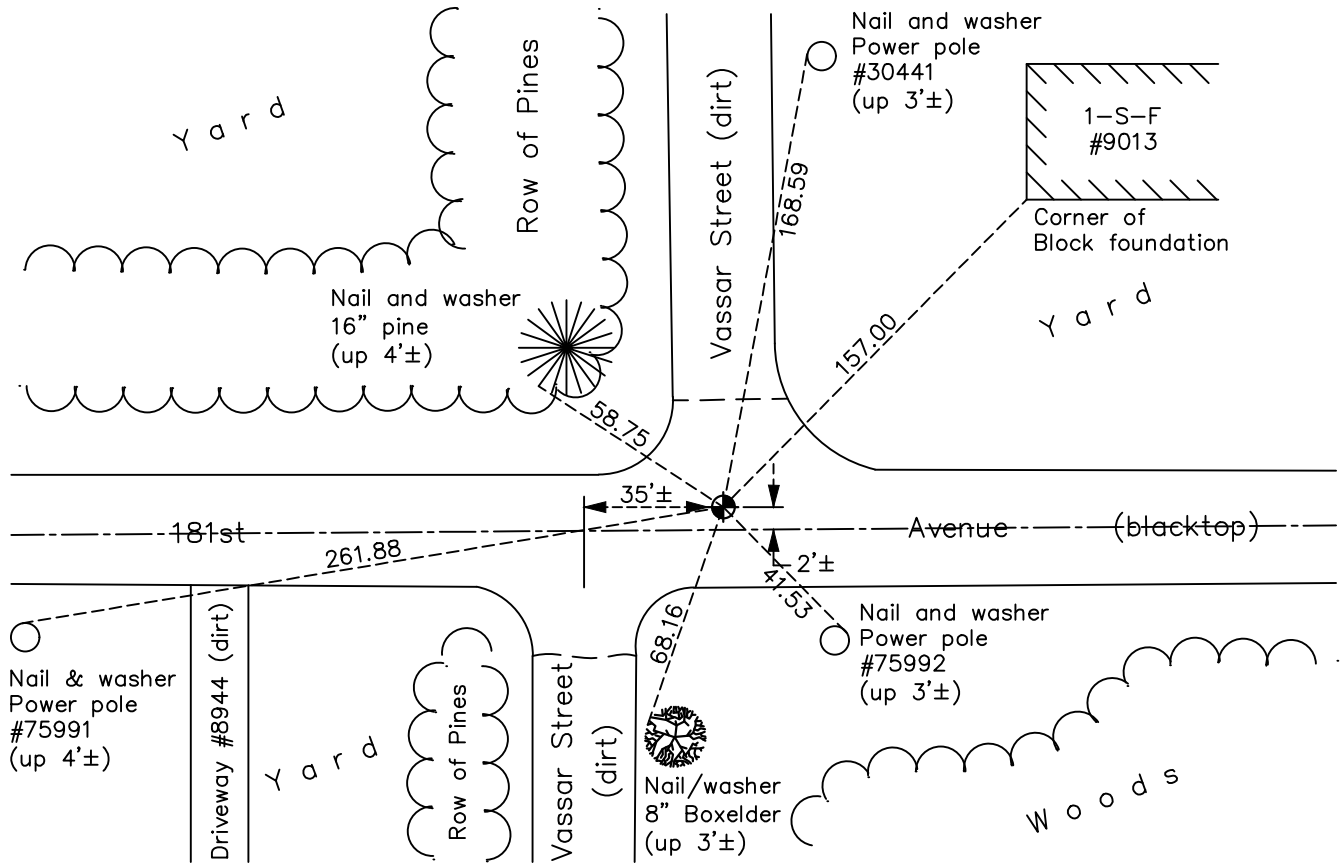

N.A.D. 1983 Coordinates
(1996 Adjustment)

County Project Coordinates	
Northing	<u>195505.4874</u>
Easting	<u>558380.0867</u>
Date	<u>6/16/03</u>

Revision Date
7/18/2022

I hereby certify that this United States public land survey monument record is correct and complete to the best of my knowledge and belief.

David Zieglmeier Date 12/7/23

David Zieglmeier Anoka County Surveyor
Minnesota License Number 46179

HISTORY OF GOVERNMENT CORNER

Page No. 3

County of Anoka

State of Minnesota

Northeast Corner of Sec. 2 Township 32 Range 22

CORNER HISTORY:

May 1965 - Don C. Hult found a 1" iron pipe down 0.7'± and updated ties.

August 22, 1968 - Found 3/4" iron pipe down 0.7' tied by Don C. Hult. Replaced iron pipe with a cast iron monument down 0.6'±. Updated ties.

June 5, 1973 - Found cast iron monument and updated ties.

August 8, 1976 - Found cast iron monument and updated ties.

May 29, 1985 - Found cast iron monument and updated ties prior to road construction. Removed monument.

July 14, 1986 - Set cast iron monument after construction. Updated ties.

February 3, 1988 - Found cast iron monument and updated ties.

August 14, 1989 - Found cast iron monument and updated ties.

August 10, 1995 - Found cast iron monument and updated ties.

June 16, 2003 - Established NAD 1983 (1996 adj.) Anoka County project coordinates by static GPS methods.

November 5, 2007 - Found cast iron monument and updated ties.

October 7, 2014 - Found cast iron monument. Verified position by VRS GPS methods. Updated ties.

June 14, 2019 - Found cast iron monument, verified position by VRS GPS methods and updated ties prior to road construction. Removed monument.

September 27, 2019 - Set cast iron monument flush after construction using static GPS methods. Verified position by VRS GPS methods. Update ties.

May 26, 2022 - Found cast iron monument, verified position by VRS GPS method and updated ties