

CERTIFICATE OF LOCATION OF GOVERNMENT CORNER

County of Anoka

State of Minnesota


Northeast Corner of Sec. 4 Township 32 Range 22

On the 15th day of March, 1977, the described corner was evidenced by a concrete monument

and to perpetuate the location of said corner, at the exact location thereof, a permanent marker was placed consisting of a 2" iron pipe

AND on the 3rd day of January, 2020, said permanent marker was found up 4.5'± slightly leaning and the ties were updated

Updated reference ties are as shown below.

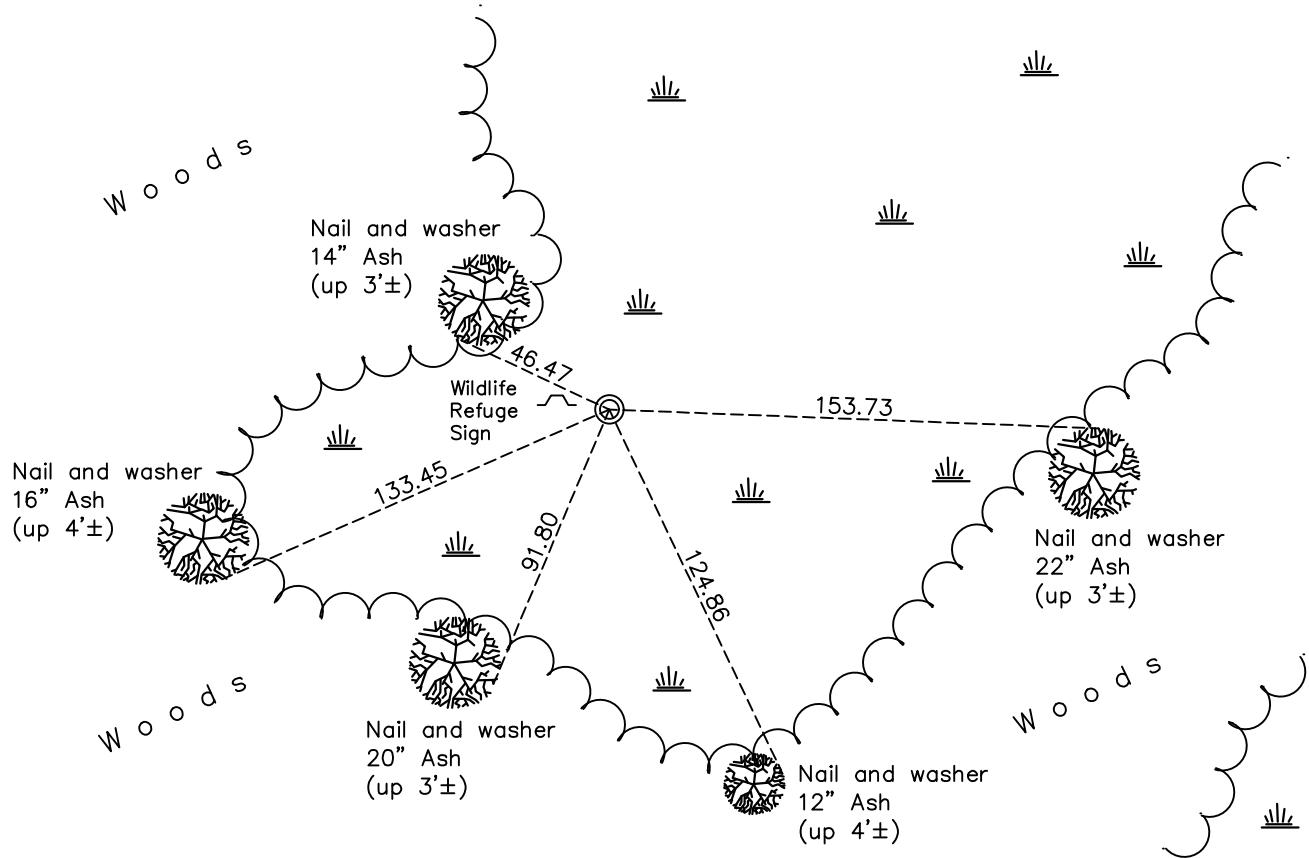

Revision Date

4/10/20

N.A.D. 1983 Coordinates
(1996 Adjustment)

County Project Coordinates

Northing 195520.8614

Easting 547834.4900

Date 5/03/05

I hereby certify that this United States public land survey monument record is correct and complete to the best of my knowledge and belief.

David M Zieglmeier Date 1/7/22

David Zieglmeier Anoka County Surveyor

Minnesota License Number 46179

HISTORY OF GOVERNMENT CORNER

Page No. 8

County of Anoka

State of Minnesota

Northeast Corner of Sec. 4 Township 32 Range 22

CORNER HISTORY:

March 15, 1977 - Found concrete monument in poor condition and replaced with a red and white iron pipe with sign attached. Updated ties.

August 10, 1979 - Found red and white iron pipe and updated ties.

August 13, 1985 - Found red and white iron pipe and updated ties.

September 1, 1989 - Found red and white iron pipe and updated ties.

August 14, 1995 - Found 2" red and white iron pipe and updated ties.

May 3, 2005 - Established NAD 1983 (1996 adj.) Anoka County project coordinates by static GPS methods.

December 11, 2007 - Found red and white iron pipe and updated ties.

December 12, 2014 - Found red and white iron pipe up 4.5'±. Verified position by VRS GPS methods. Updated ties.

January 3, 2020 - Found red and white iron pipe up 4.5'± and slightly leaning. Verified position by VRS GPS methods. Updated ties.