

# CERTIFICATE OF LOCATION OF GOVERNMENT CORNER

County of Anoka


State of Minnesota

E. 16<sup>TH</sup> OF  
S.E. QTR. Corner of Sec. 6 Township 32 Range 22

I hereby certify that on the 17 day of MARCH, 1977, I found the described corner which was evidenced by CONCRETE MON.

and I further certify that to perpetuate the location of said corner, I did, at the exact location thereof, place a permanent marker consisting of SAME SIGN AND POST ON  
NORTH SIDE

which reference or witness monuments are located in the manner following:

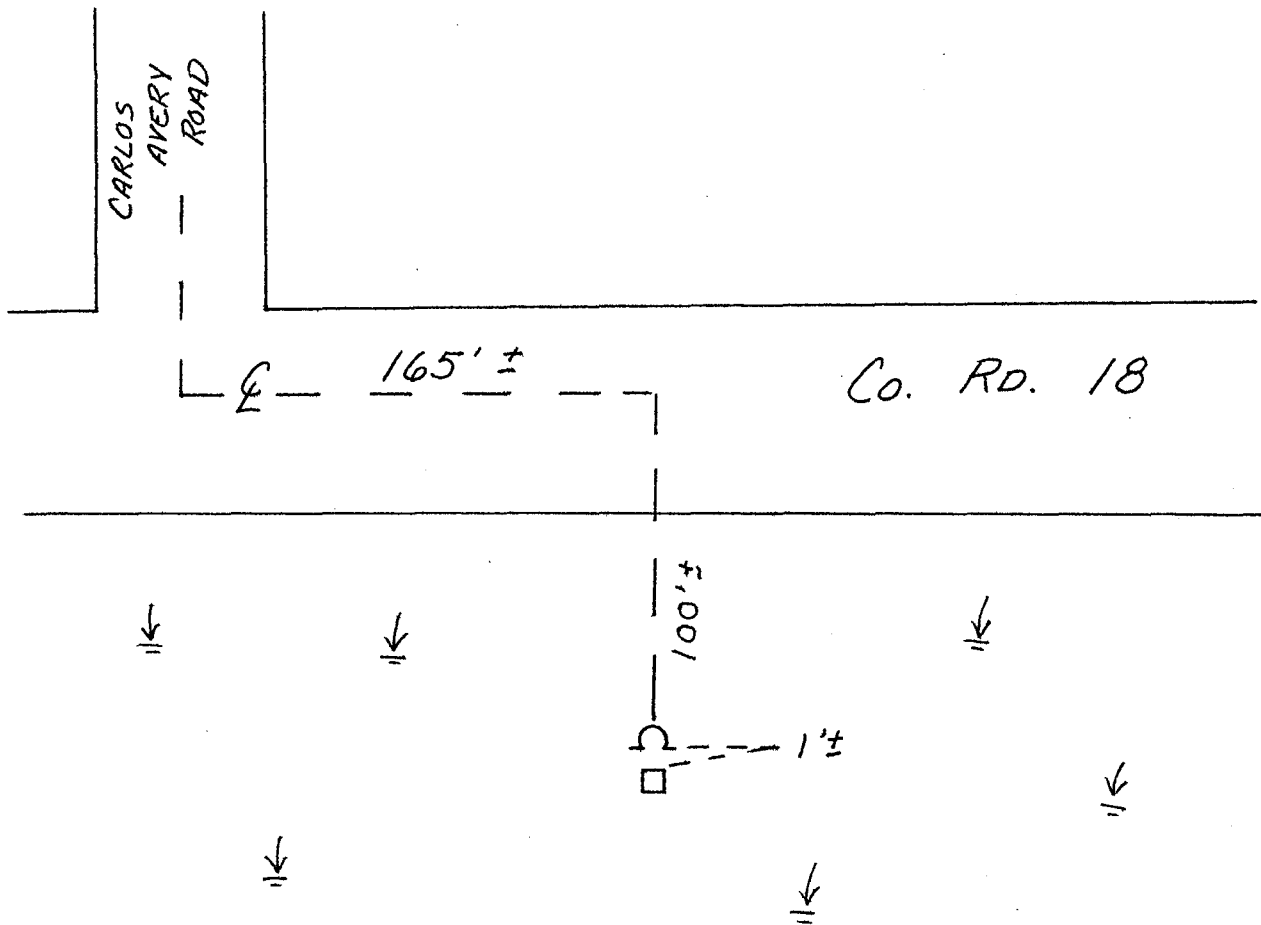

Revised date	Revised date	Revised date
8-2-85		

