

CERTIFICATE OF LOCATION OF GOVERNMENT CORNER

County of Anoka

State of Minnesota


West 1/4 Corner of Sec. 4 Township 32 Range 22

On the 6th day of March, 1974, the described corner was evidenced by an iron pipe set using Carlos Avery information

and to perpetuate the location of said corner, at the exact location thereof, a permanent marker was placed consisting of a cast iron monument

AND on the 31st day of May, 2022, said permanent marker was found down 2'± and the ties were updated

Updated reference ties are as shown below.

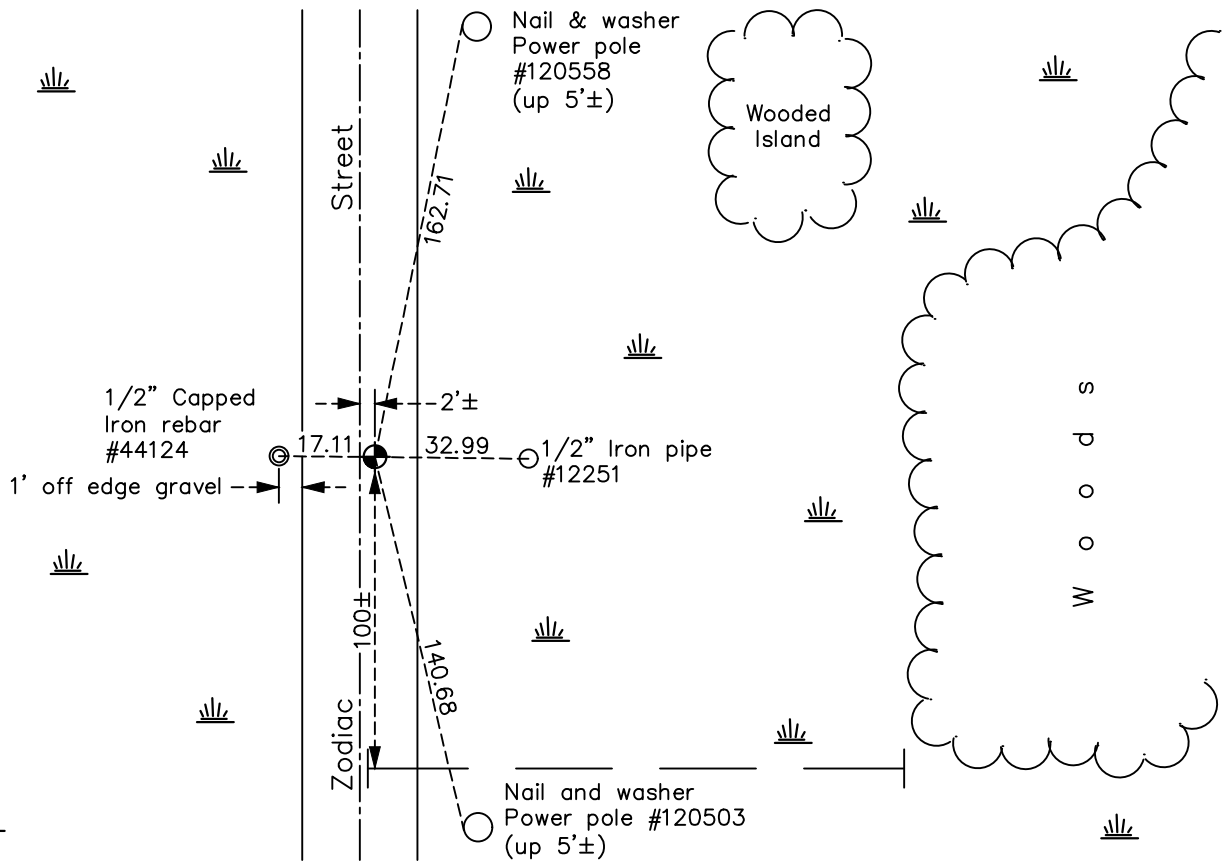

Revision Date
 8/12/2022

N.A.D. 1983 Coordinates
 (1996 Adjustment)

County Project Coordinates	
Northing	<u>193102.5610</u>
Easting	<u>542630.4687</u>
Date	<u>6/05/03</u>

I hereby certify that this United States public land survey monument record is correct and complete to the best of my knowledge and belief.
David Zieglmeier Date 12/7/23
 David Zieglmeier Anoka County Surveyor
 Minnesota License Number 46179

HISTORY OF GOVERNMENT CORNER

Page No. 17

County of Anoka

State of Minnesota

West 1/4 Corner of Sec. 4 Township 32 Range 22

CORNER HISTORY:

March 6, 1974 - Set 1/2" iron pipe down 0.5'± using old Carlos Avery information. Established ties to iron pipe.

August 3, 1976 - Found 1/2" iron pipe and replaced with a cast iron monument down 1'±. Updated ties.

August 24, 1979 - Found cast iron monument and updated ties.

August 21, 1989 - Found cast iron monument and updated ties.

August 9, 1995 - Found cast iron monument and updated ties.

June 5, 2003 - Established NAD 1983 (1996 adj.) Anoka County project coordinates by static GPS methods.

February 27, 2008 - Found cast iron monument down 2'± and updated ties.

September 9, 2014 - Found cast iron monument down 2'± and updated ties.

August 2, 2019 - Found cast iron monument down 2'± and updated ties.

May 31, 2022 - Found cast iron monument down 2'± and verified position by VRS GPS method. Updated ties.