

CERTIFICATE OF LOCATION OF GOVERNMENT CORNER

County of Anoka


State of Minnesota

West $\frac{1}{16}$ of the NW $\frac{1}{4}$ Corner of Sec. 4 Township 32 Range 22

I hereby certify that on the 28 day of February, 1974, I found the described corner which was evidenced by Concrete Monument

and I further certify that to perpetuate the location of said corner, I did, at the exact location thereof, place a permanent marker consisting of Cast Iron Monument

which reference or witness monuments are located in the manner following:

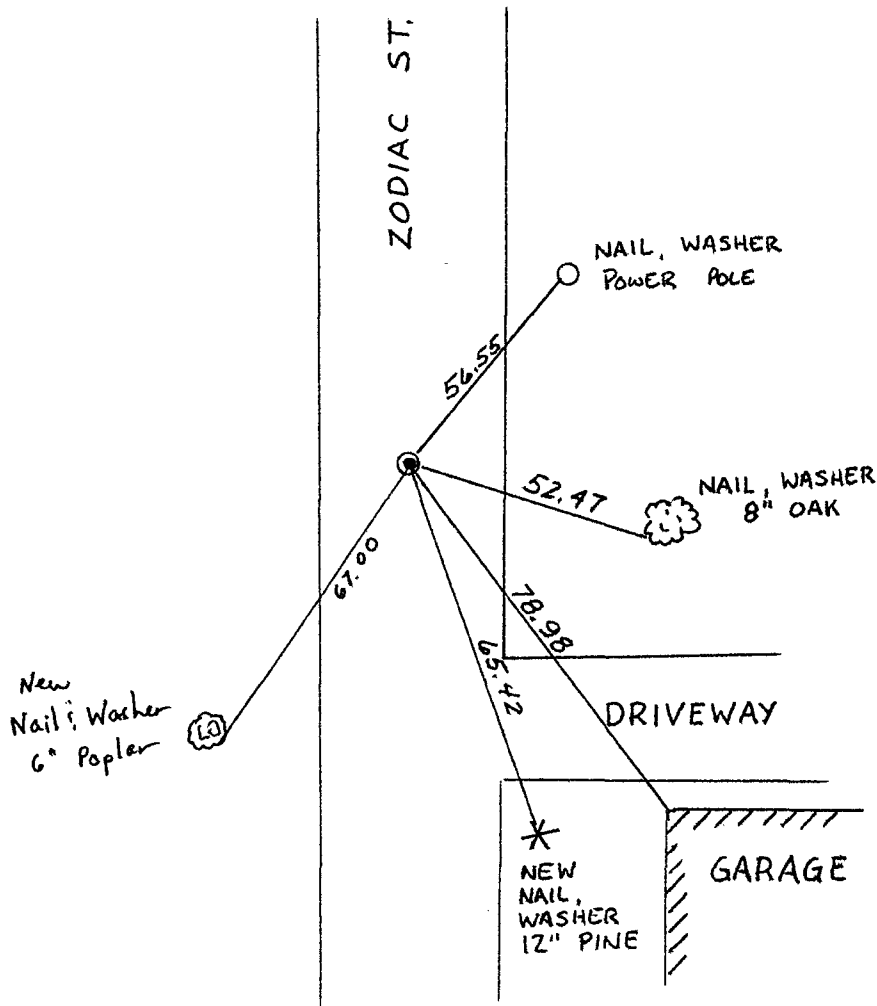

Revised date	Revised date	Revised date
8-5-85		
2-10-88		
7-2-90		

