

# CERTIFICATE OF LOCATION OF GOVERNMENT CORNER

WEST 1/6 COR. ON County of Anoka


State of Minnesota

THE SOUTHWEST 1/4 Corner of Sec. 2 Township 32 Range 22

I hereby certify that on the 23 day of SEPTEMBER, 1969, I found the described corner which was evidenced by TIES TAKEN BY JIM KURTH, APRIL, 1968

and I further certify that to perpetuate the location of said corner, I did, at the exact location thereof, place a permanent marker consisting of 1/2" IRON PIPE

which reference or witness monuments are located in the manner following:

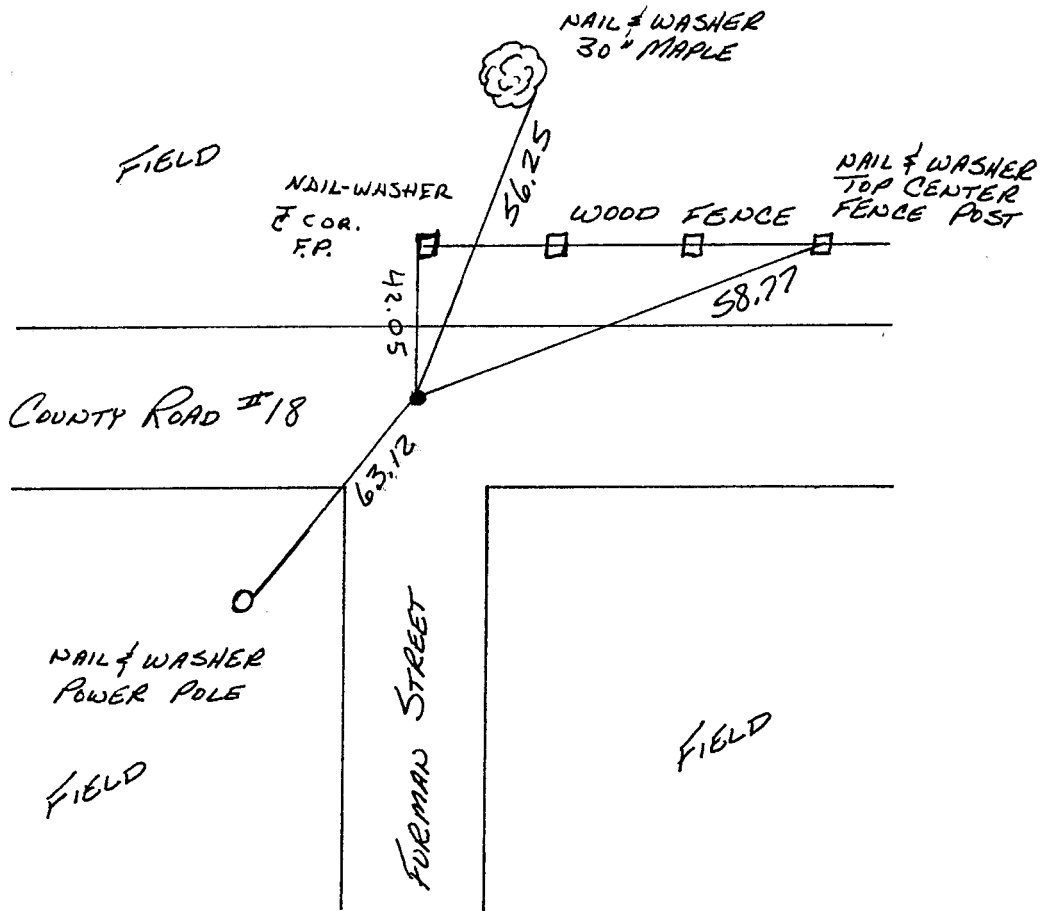

Revised date	By
6-8-87	LARSON
8-15-89	

Minnesota State Plane Coordinates  
South Zone

Y \_\_\_\_\_ X \_\_\_\_\_

County Surveyor

Date

Registered Land Surveyor No. \_\_\_\_\_