

CERTIFICATE OF LOCATION OF GOVERNMENT CORNER

County of Anoka

State of Minnesota


South 1/4 Corner of Sec. 1 Township 32 Range 22

On the 27th day of December, 1968, the described corner was evidenced by a 3/4" iron pipe

and to perpetuate the location of said corner, at the exact location thereof, a permanent marker was placed consisting of a cast iron monument with a sign and post on the north side

AND on the 31st day of May, 2022, said permanent marker was found up 0.2'± and the ties were updated

Updated reference ties are as shown below.

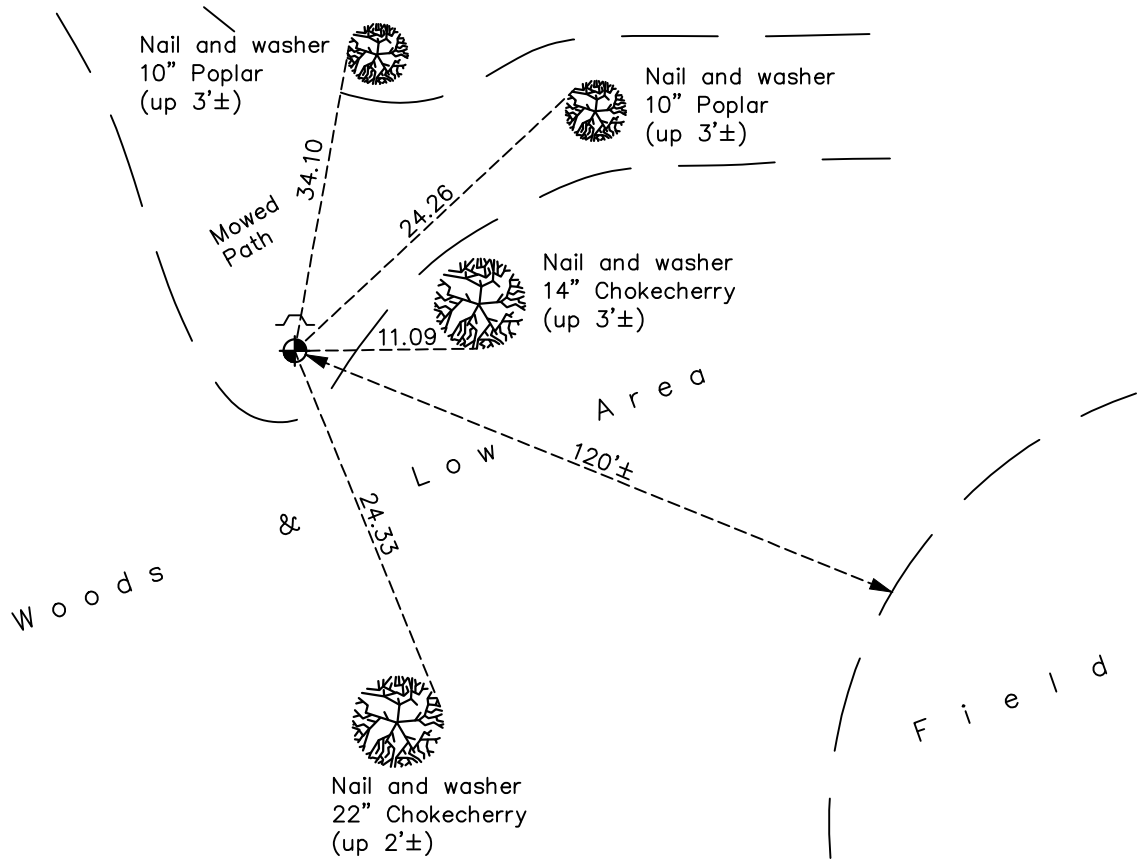

Revision Date
8/12/2022

N.A.D. 1983 Coordinates
 (1996 Adjustment)

| County Project Coordinates | |
|----------------------------|--------------------|
| Northing | <u>190383.3310</u> |
| Easting | <u>561008.8283</u> |
| Date | <u>4/20/05</u> |

I hereby certify that this United States public land survey monument record is correct and complete to the best of my knowledge and belief.

David Zieglmeier Date 12/7/23

David Zieglmeier Anoka County Surveyor
 Minnesota License Number 46179

HISTORY OF GOVERNMENT CORNER

Page No. 29

County of Anoka

State of Minnesota

South 1/4 Corner of Sec. 1 Township 32 Range 22

CORNER HISTORY:

December 27, 1968 - Found 3/4" iron pipe and updated ties.

August 4, 1986 - Found 3/4" iron pipe and replaced with a cast iron monument. Updated ties.

June 14, 1990 - Found cast iron monument and updated ties.

August 10, 1995 - Found cast iron monument and updated ties.

April 20, 2005 - Found cast iron monument. Updated ties. Established NAD 1983 (1996 adj.) Anoka County project coordinates by static GPS methods.

October 8, 2014 - Found cast iron monument up 0.2'± and updated ties.

September 24, 2019 - Found cast iron monument up 0.2'± and updated ties.

May 31, 2022 - Found cast iron monument up 0.2'±, verified position by VRS GPS method and updated ties.