

CERTIFICATE OF LOCATION OF GOVERNMENT CORNER

County of Anoka

State of Minnesota


South 1/4 Corner of Sec. 5 Township 32 Range 22

On the 2nd day of February, 1977, the described corner was evidenced by a concrete monument

and to perpetuate the location of said corner, at the exact location thereof, a permanent marker was placed consisting of the same concrete monument

AND on the 11th day of December, 2014, said permanent marker was found to have been replaced with a 2" square steel Telspar monument up 6'± and leaning slightly southeasterly.

Updated reference ties are as shown below.

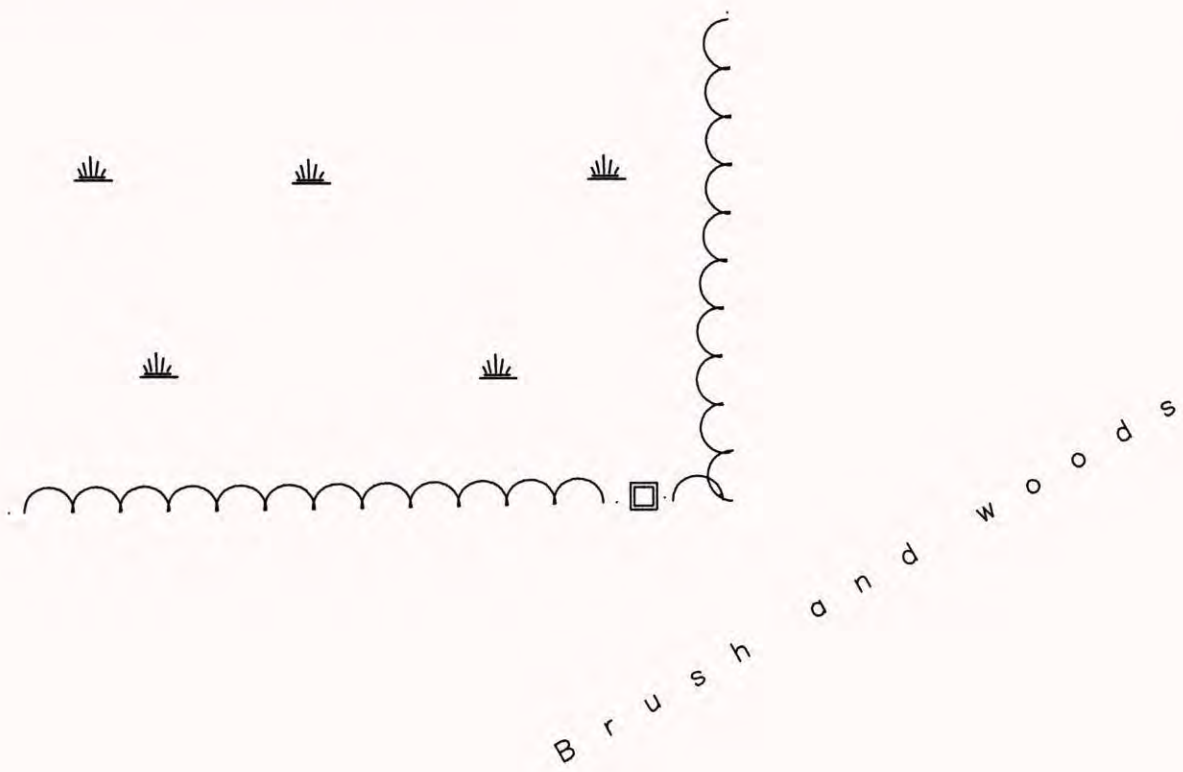

Revision Date
5/12/15

N.A.D. 1983 Coordinates
(1996 Adjustment)

County Project Coordinates	
Northing	<u>190457.1176</u>
Easting	<u>540013.5765</u>
Date	<u>3/21/06</u>

I hereby certify that this United States public land survey monument record is correct and complete to the best of my knowledge and belief.

Larry D. Hoium Date 5/12/15

Larry D. Hoium, Anoka County Surveyor

Minnesota License Number 18165