

CERTIFICATE OF LOCATION OF GOVERNMENT CORNER

County of Anoka

State of Minnesota

Witness Corner of Sec. 14 Township 32 Range 22


(on east line of NE 1/4)

On the 14th day of February, 1979, the described corner was evidenced by area resurvey

and to perpetuate the location of said corner, at the exact location thereof, a permanent marker was placed consisting of a red and white iron pipe

AND on the 16th day of December, 2014, said permanent marker was found to be a 2" square steel Telespar monument up 4'± with a sign attached facing north. The ties were updated.

Updated reference ties are as shown below.

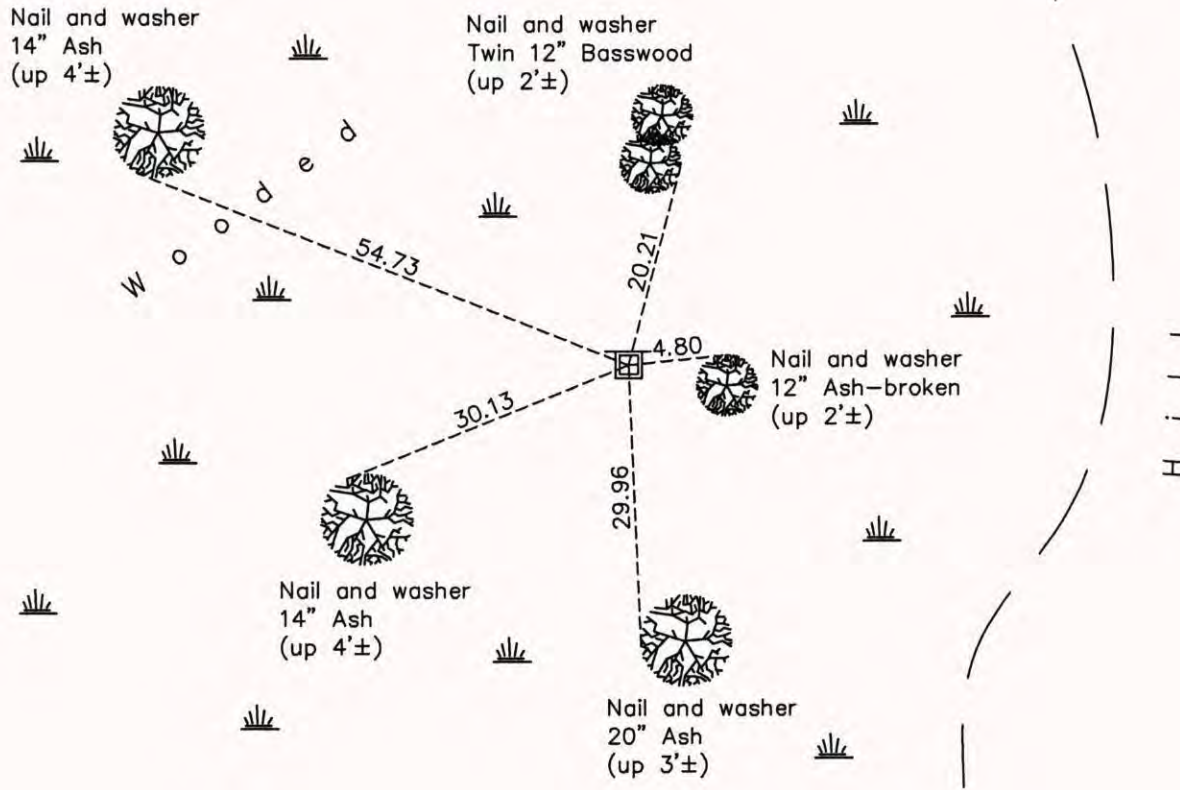

N

W ANOKA COUNTY SURVEYOR E

S

Revision Date

5/20/15

N.A.D. 1983 Coordinates
(1996 Adjustment)

| County Project Coordinates | |
|----------------------------|-------------|
| Northing | 184566.3488 |
| Easting | 558412.2885 |
| Date | 1/11/06 |

I hereby certify that this United States public land survey monument record is correct and complete to the best of my knowledge and belief.

Larry D. Hoium Date 5/20/15

Larry D. Hoium, Anoka County Surveyor

Minnesota License Number 18165