

# CERTIFICATE OF LOCATION OF GOVERNMENT CORNER

County of Anoka

State of Minnesota


## North 1/4 Corner of Sec. 16 Township 32 Range 22

On the 27th day of December, 1976, the described corner was evidenced by area resurvey

and to perpetuate the location of said corner, at the exact location thereof, a permanent marker was placed consisting of a red and white iron pipe

AND on the 12th day of December, 2014, said permanent marker was found up 1.5'± with a sign attached facing south and leaning slightly easterly.

Updated reference ties are as shown below.

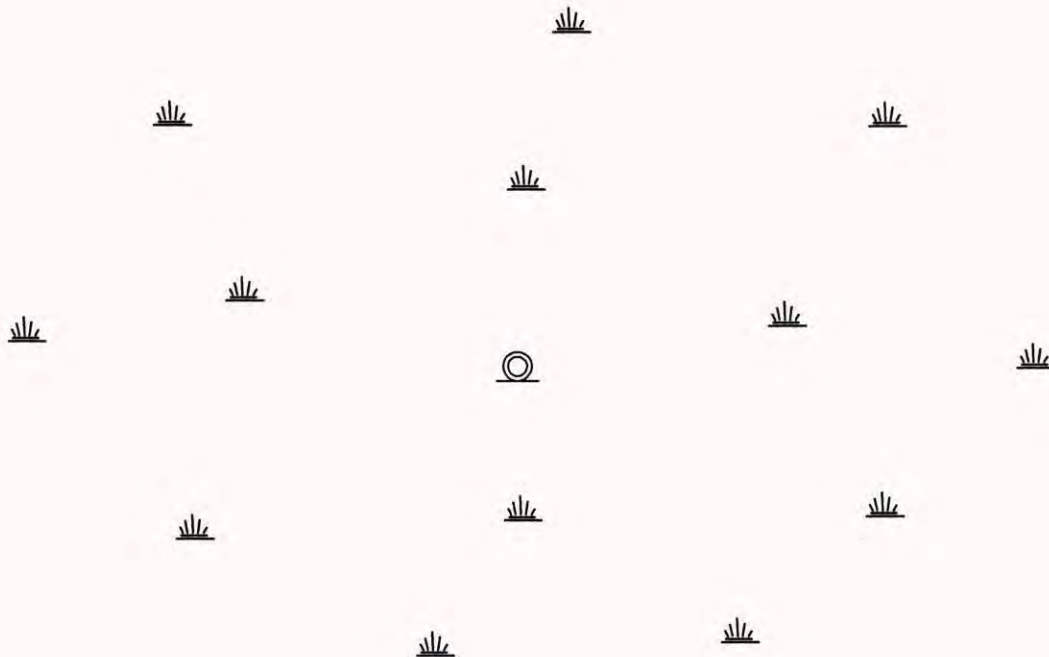

ANOKA COUNTY SURVEYOR

Revision Date

6/02/15

N.A.D. 1983 Coordinates (1996 Adjustment)	
County Project Coordinates	
Northing	<u>185213.5677</u>
Easting	<u>545353.5351</u>
Date	<u>2/15/06</u>

I hereby certify that this United States public land survey monument record is correct and complete to the best of my knowledge and belief.

Date 6/02/15

Larry D. Hoium, Anoka County Surveyor  
 Minnesota License Number 18165