

CERTIFICATE OF LOCATION OF GOVERNMENT CORNER

County of Anoka

State of Minnesota


South 1/4 Corner of Sec. 8 Township 32 Range 22

On the 15th day of February, 1980, the described corner was evidenced by a 1" iron pipe

and to perpetuate the location of said corner, at the exact location thereof, a permanent marker was placed consisting of a 2" square steel Telespar monument

AND on the 15th day of December, 2014, said permanent marker was found up 4'± with a sign attached facing south

Updated reference ties are as shown below.

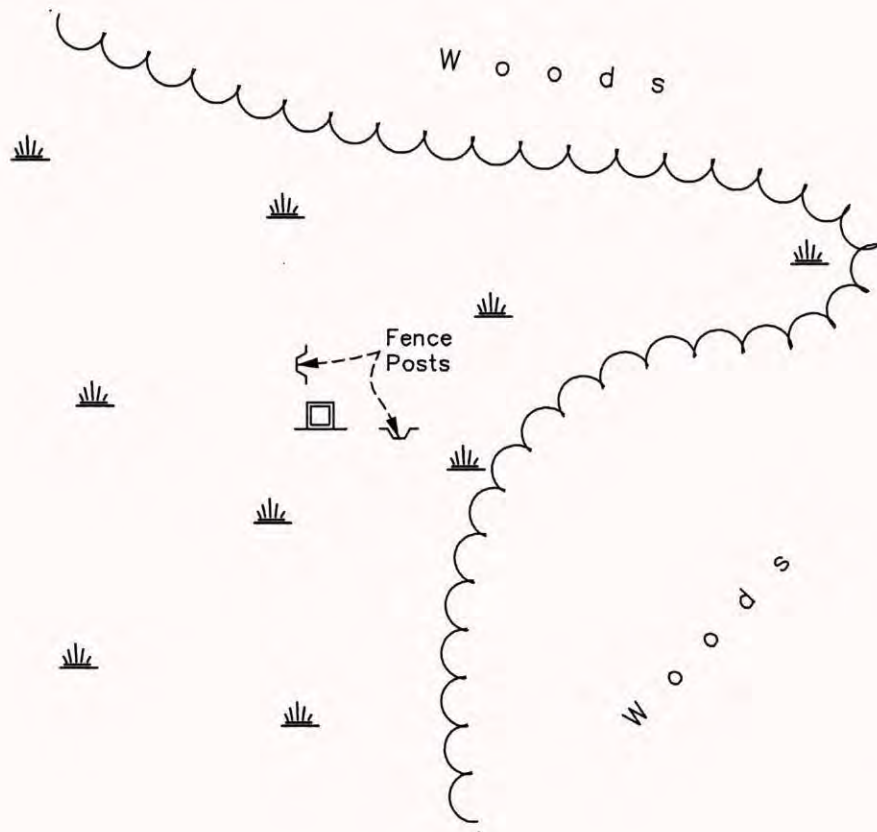

Revision Date
6/02/15

N.A.D. 1983 Coordinates
(1996 Adjustment)

| County Project Coordinates | |
|----------------------------|--------------------|
| Northing | <u>185194.7313</u> |
| Easting | <u>540071.2278</u> |
| Date | <u>2/13/06</u> |

I hereby certify that this United States public land survey monument record is correct and complete to the best of my knowledge and belief.

Larry D. Hoium Date 6/02/15

Larry D. Hoium, Anoka County Surveyor
Minnesota License Number 18165