

CERTIFICATE OF LOCATION OF GOVERNMENT CORNER

County of Anoka

State of Minnesota


West 1/4 Corner of Sec. 16 Township 32 Range 22

On the 28th day of October, 1971, the described corner was evidenced by a concrete monument

and to perpetuate the location of said corner, at the exact location thereof, a permanent marker was placed consisting of the same concrete monument with a sign and post on the east side and a steel post on the west side

AND on the 10th day of March, 2015, said permanent marker was found and the ties were updated. Steel post on west side was found missing.

Updated reference ties are as shown below.

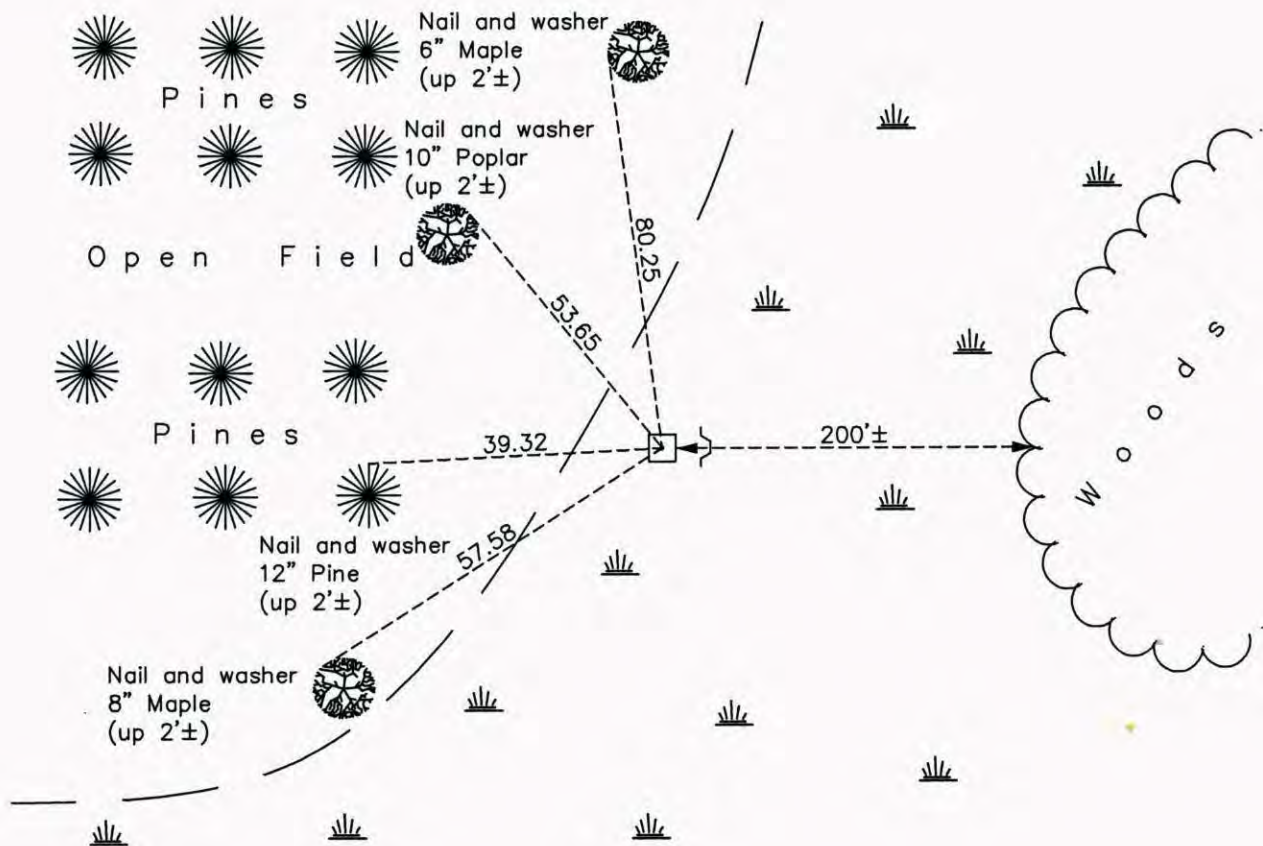

Revision Date
6/11/15

N.A.D. 1983 Coordinates
(1996 Adjustment)

County Project Coordinates	
Northing	182570.9529
Easting	542724.6009
Date	2/21/06

I hereby certify that this United States public land survey monument record is correct and complete to the best of my knowledge and belief.

Larry D. Hoium Date 6/11/15

Larry D. Hoium, Anoka County Surveyor

Minnesota License Number 18165