

CERTIFICATE OF LOCATION OF GOVERNMENT CORNER

County of Anoka



State of Minnesota

Southeast Corner of Sec. 13 Township 32 Range 22

On the 12th day of February, 1979, the described corner was evidenced by reties

and to perpetuate the location of said corner, at the exact location thereof, a permanent marker was placed consisting of a red and white iron pipe

AND on the 16th day of June, 2023, said permanent marker was found bent, laying down.
Replaced with Telspar with punched cap, set up 0.5'±, sign set on East side. Ties updated after setting
Updated reference ties are as shown below.

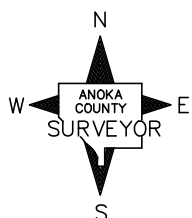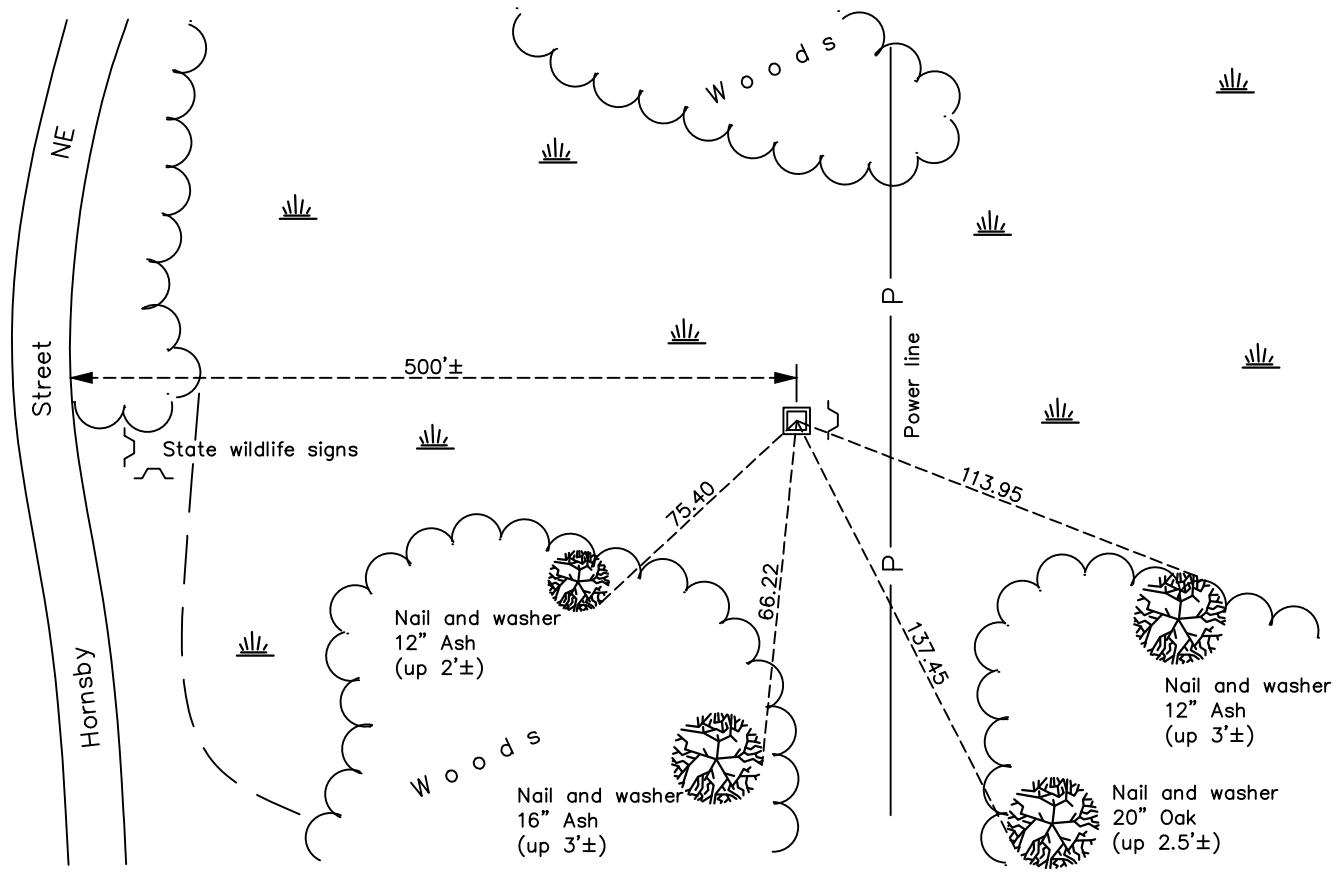

Revision Date
6/21/2023

N.A.D. 1983 Coordinates
 (1996 Adjustment)

County Project Coordinates	
Northing	<u>179880.5946</u>
Easting	<u>563657.3255</u>
Date	<u>1/17/06</u>

I hereby certify that this United States public land survey monument record is correct and complete to the best of my knowledge and belief.
David Zieglmeier Date 6/28/23
 David Zieglmeier Anoka County Surveyor
 Minnesota License Number 46179

HISTORY OF GOVERNMENT CORNER

Page No. 65

County of Anoka

State of Minnesota

Southeast Corner of Sec. 13 Township 32 Range 22

CORNER HISTORY:

January 20, 1966 - Nothing found at location. Set 1/2" x 10' red and white iron pipe up 3' using MNDOT angles and distances from Interstate 35E right of way plat. Established ties to iron pipe.

July 15, 1970 - Found red and white iron pipe and updated ties.

January 15, 1974 - Found red and white iron pipe and updated ties.

August 10, 1976 - Found red and white iron pipe bent and ties gone due to power line construction.

February 6, 1978 - Found red and white iron pipe bent and ties gone due to power line construction.

February 12, 1979 - Found red and white iron pipe and updated ties. Pipe position fit well with section closure.

August 14, 1985 - Found red and white iron pipe and updated ties.

June 13, 1990 - Found red and white iron pipe and updated ties.

August 21, 1995 - Found red and white iron pipe and updated ties.

January 17, 2006 - Found red and white iron pipe. Updated ties. Established NAD 1983 (1996 adj.) Anoka County project coordinates by static GPS methods.

June 16, 2023 - Found 1 1/2" pipe bent and laying down. Replaced monument with 2" square Telspar with punched cap set up 0.5'± set to published coordinates using ACS RTK GPS method. Updated ties after setting. Sign and post added to East side, facing West.