

CERTIFICATE OF LOCATION OF GOVERNMENT CORNER

County of Anoka

State of Minnesota


South 1/4 Corner of Sec. 14 Township 32 Range 22

On the 17th day of November, 1964, the described corner was evidenced by area resurvey

and to perpetuate the location of said corner, at the exact location thereof, a permanent marker was placed consisting of a cast iron monument

AND on the 6th day of June, 2023, said permanent marker was found flush to road surface. Position of corner verified by ACS RTK GPS method and the ties were updated.

Updated reference ties are as shown below.

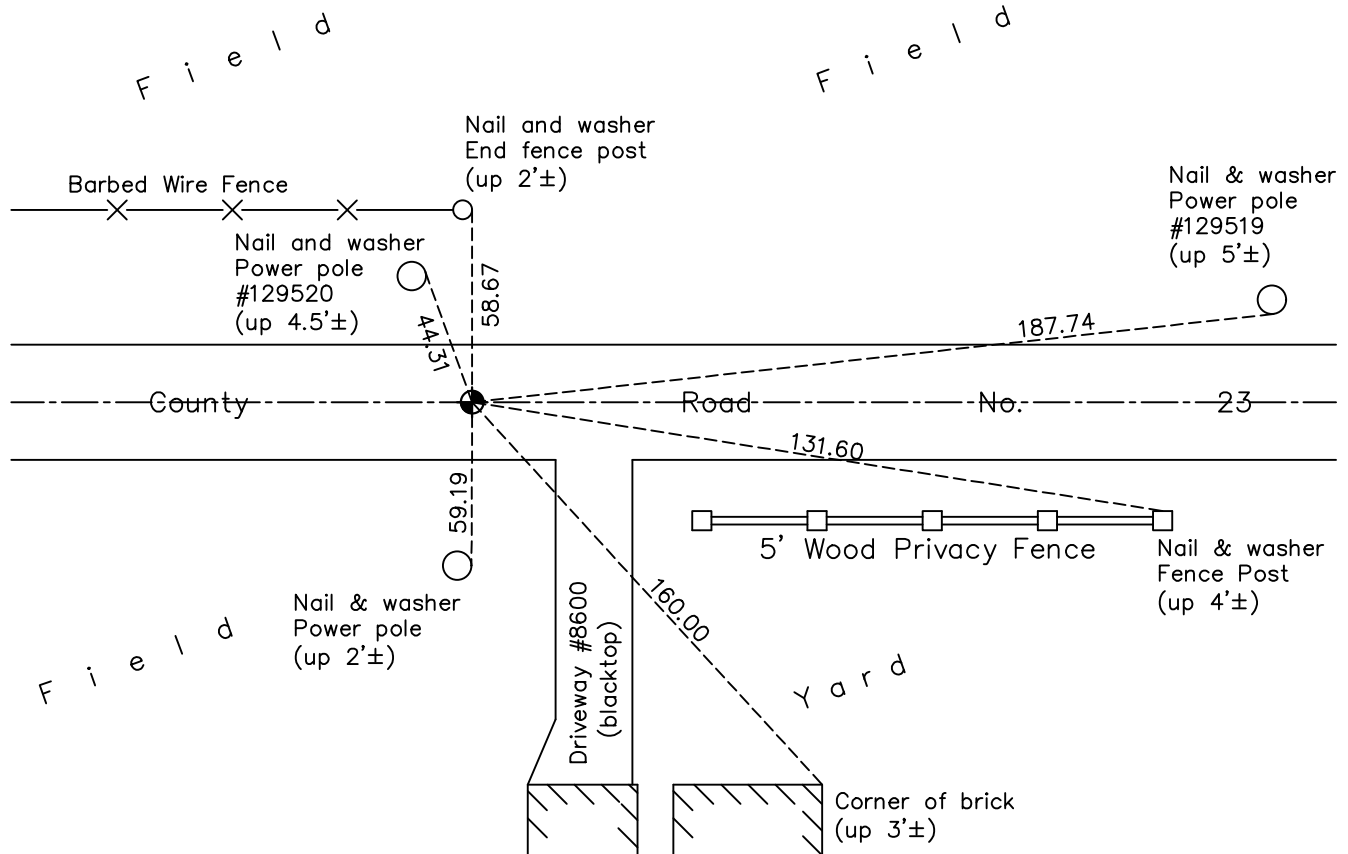

Revision Date
 6/13/2023

N.A.D. 1983 Coordinates
 (1996 Adjustment)

County Project Coordinates	
Northing	179904.6402
Easting	555859.1022
Date	6/18/03

I hereby certify that this United States public land survey monument record is correct and complete to the best of my knowledge and belief.
David Zieglmeier Date 12/8/23
 David Zieglmeier Anoka County Surveyor
 Minnesota License Number 46179

HISTORY OF GOVERNMENT CORNER

Page No. 68

County of Anoka

State of Minnesota

South 1/4 Corner of Sec. 14 Township 32 Range 22

CORNER HISTORY:

November 17, 1964 - Set 3/4" x 3-1/2" bolt down 1/2" in concrete road using area resurvey. Established ties to bolt.

June 29, 1970 - Found 3/4" x 3-1/2" bolt flush in concrete road and updated ties.

June 8, 1973 - Found 3/4" x 3-1/2" bolt in concrete road and updated ties.

August 10, 1976 - Found 3/4" x 3-1/2" bolt in concrete road and updated ties.

August 1, 1979 - Found 3/4" x 3-1/2" bolt in concrete road and updated ties.

July 13, 1982 - Found P.K. nail and updated ties.

December 9, 1987 - Found P.K. nail and updated ties.

April 21, 1989 - Found 1/2" iron pipe and updated ties.

August 8, 1989 - Found 1/2" iron pipe and updated ties.

August 11, 1995 - Found 1/2" iron pipe and updated ties.

July 17, 1998 - Found 1/2" iron pipe and set construction ties prior to road construction.

October 6, 1998 - Found 1/2" iron pipe and updated ties.

June 18, 2003 - Established NAD 1983 (1996 adj.) Anoka County project coordinates by static GPS methods.

November 15, 2007 - Found 1/2" iron pipe and updated ties.

October 10, 2014 - Found cast iron monument and updated ties.

August 16, 2019 - Found cast iron monument. Verified position by VRS GPS methods. Updated ties.

June 9, 2022 - Found cast iron monument. Verified position by VRS GPS method. Updated ties.

June 6, 2023 - Found cast iron monument flush. Verified position by ACS RTK GPS method. Updated ties.