

CERTIFICATE OF LOCATION OF GOVERNMENT CORNER

County of Anoka

State of Minnesota


East 1/4 Corner of Sec. 23 Township 32 Range 22

On the 17th day of February, 1983, the described corner was evidenced by a 1/2" iron pipe

and to perpetuate the location of said corner, at the exact location thereof, a permanent marker was placed consisting of the same 1/2" iron pipe

AND on the 15th day of December, 2014, said permanent marker was found and the ties were updated

Updated reference ties are as shown below.

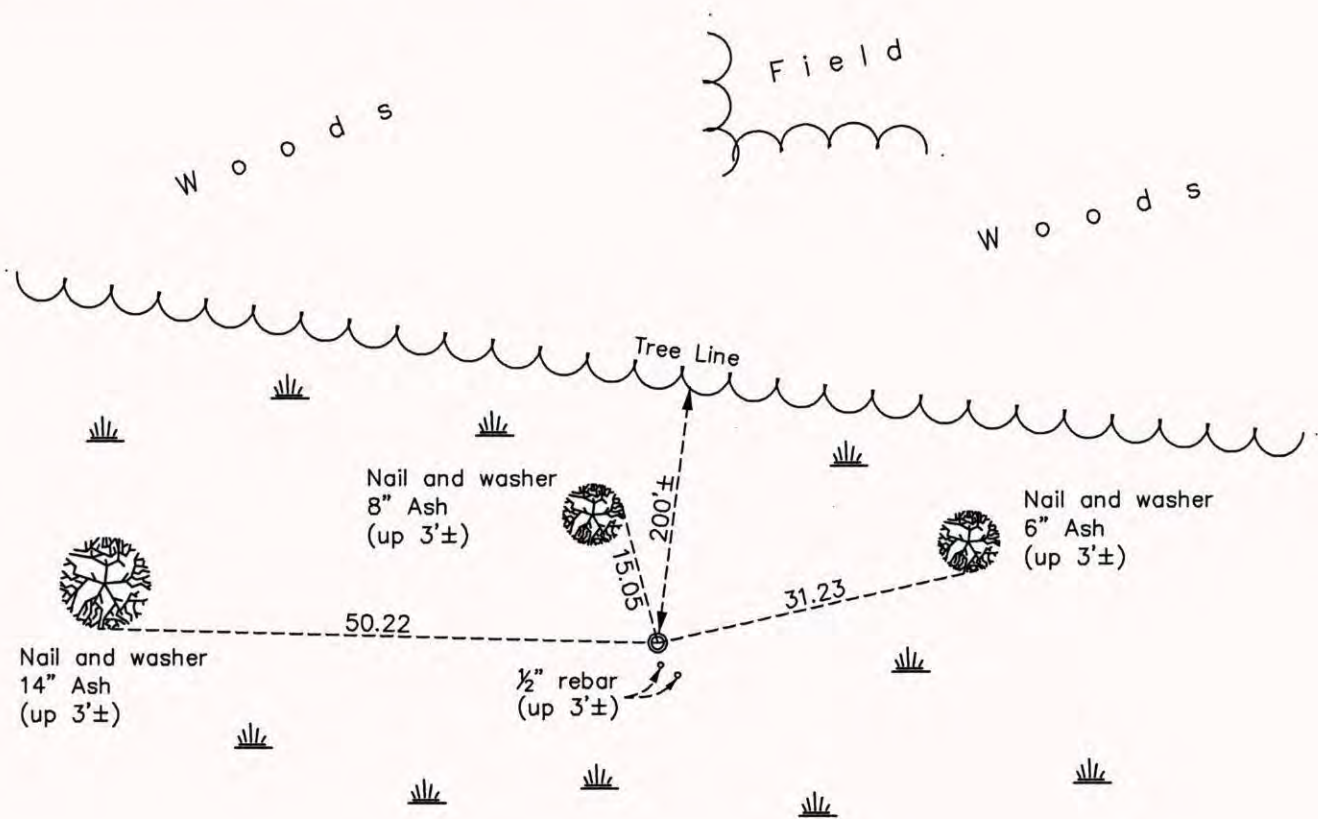

Revision Date
6/30/15

N.A.D. 1983 Coordinates
(1996 Adjustment)

County Project Coordinates	
Northing	177234.3682
Easting	558438.3257
Date	1/18/06

I hereby certify that this United States public land survey monument record is correct and complete to the best of my knowledge and belief.

Larry D. Hoium Date 6/30/15
 Larry D. Hoium, Anoka County Surveyor
 Minnesota License Number 18165