

CERTIFICATE OF LOCATION OF GOVERNMENT CORNER

County of Anoka

State of Minnesota


South 1/4 Corner of Sec. 24 Township 32 Range 22

On the 19th day of July, 1972, the described corner was evidenced by area resurvey

and to perpetuate the location of said corner, at the exact location thereof, a permanent marker was placed consisting of red and white iron pipe

AND on the 30th day of June, 2023, said permanent marker was replaced w/ 2" sq. steel telspar w/ alum. cap & punch mark, set up 1.5'±. Existing pipe remains. Ties established after setting.

Updated reference ties are as shown below.

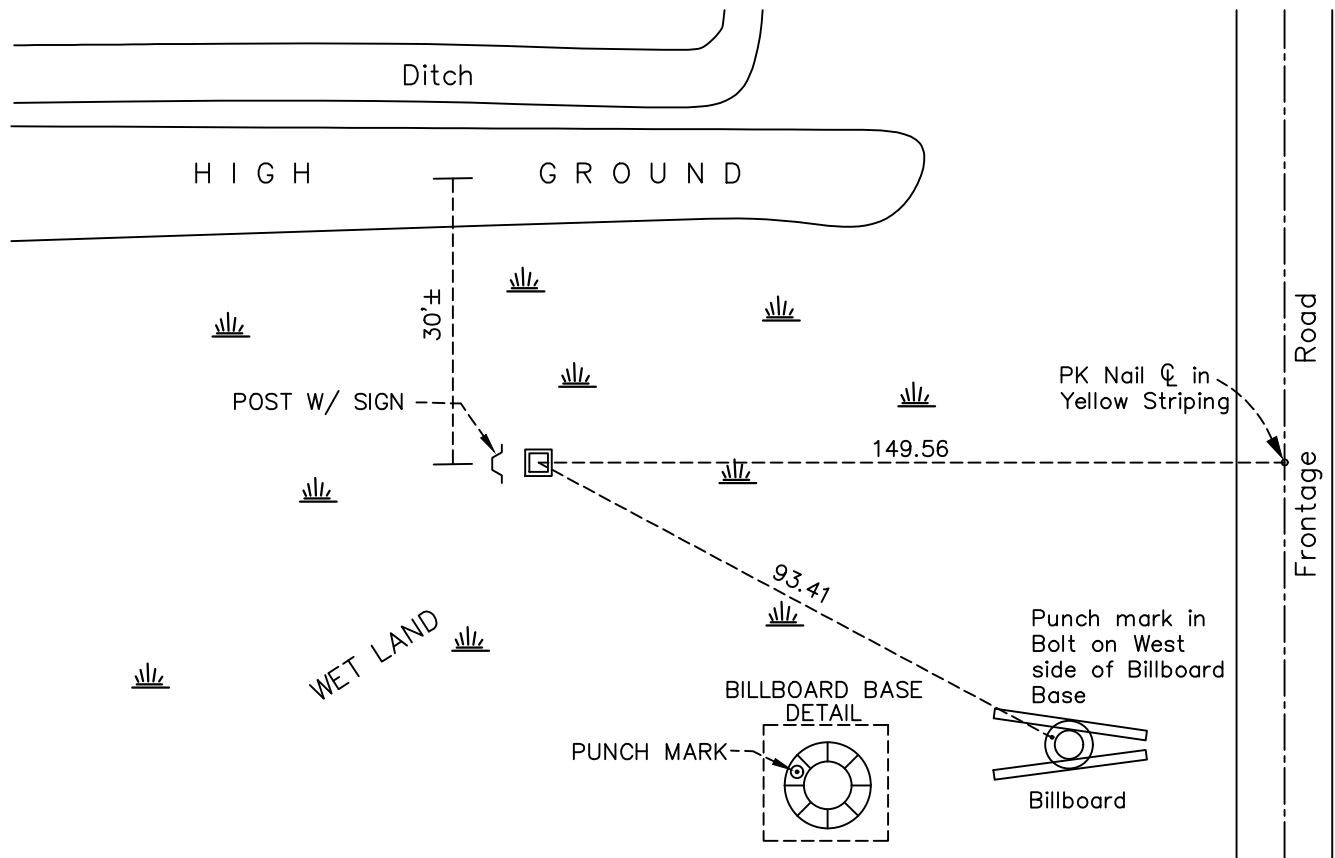

Revision Date
10/05/2023

N.A.D. 1983 Coordinates
(2011 Adjustment)

County Project Coordinates	
Northing	174623.3794
Easting	561083.1063
Date	5/24/04

I hereby certify that this United States public land survey monument record is correct and complete to the best of my knowledge and belief.

David Zieglsmeier Date 12/8/23

David M. Zieglsmeier, Anoka County Surveyor
Minnesota License Number 46179

HISTORY OF GOVERNMENT CORNER

Page No. 86

County of Anoka

State of Minnesota

South 1/4 Corner of Sec. 24 Township 32 Range 22

CORNER HISTORY:

July 19, 1972 - Set 2" Red & White Iron Pipe, up 3'±, from area resurvey and established ties.

June 13, 1973; August 10, 1976; August 3, 1979; August 7, 1985; June 13, 1990 - Found Iron Pipe and updated ties

June 30, 2023 - Existing iron pipe found laying down and broken off under water. Unable to remove Iron Pipe. Set 6' x 2" square steel Telspar on East side of existing pipe, in slightly leaning position, to West. Telspar set to published coordinates using RTK ACS GPS method with aluminum cap and punch mark, set up 1.5'±. Sign and post placed on West side of monument. Ties established after setting as all historical ties were missing.