

# CERTIFICATE OF LOCATION OF GOVERNMENT CORNER

County of Anoka

State of Minnesota


## Southwest Corner of Sec. 24 Township 32 Range 22

On the 20th day of July, 1972, the described corner was evidenced by area resurvey

and to perpetuate the location of said corner, at the exact location thereof, a permanent marker was placed consisting of a 2" square steel Telespar monument with 'Anoka County' cap on top

AND on the 15th day of June, 2023, said permanent marker was found up 3'± with a sign and post on north side. Lowered and adjusted to height of 1.5'±. No ties available.

Updated reference ties are as shown below.

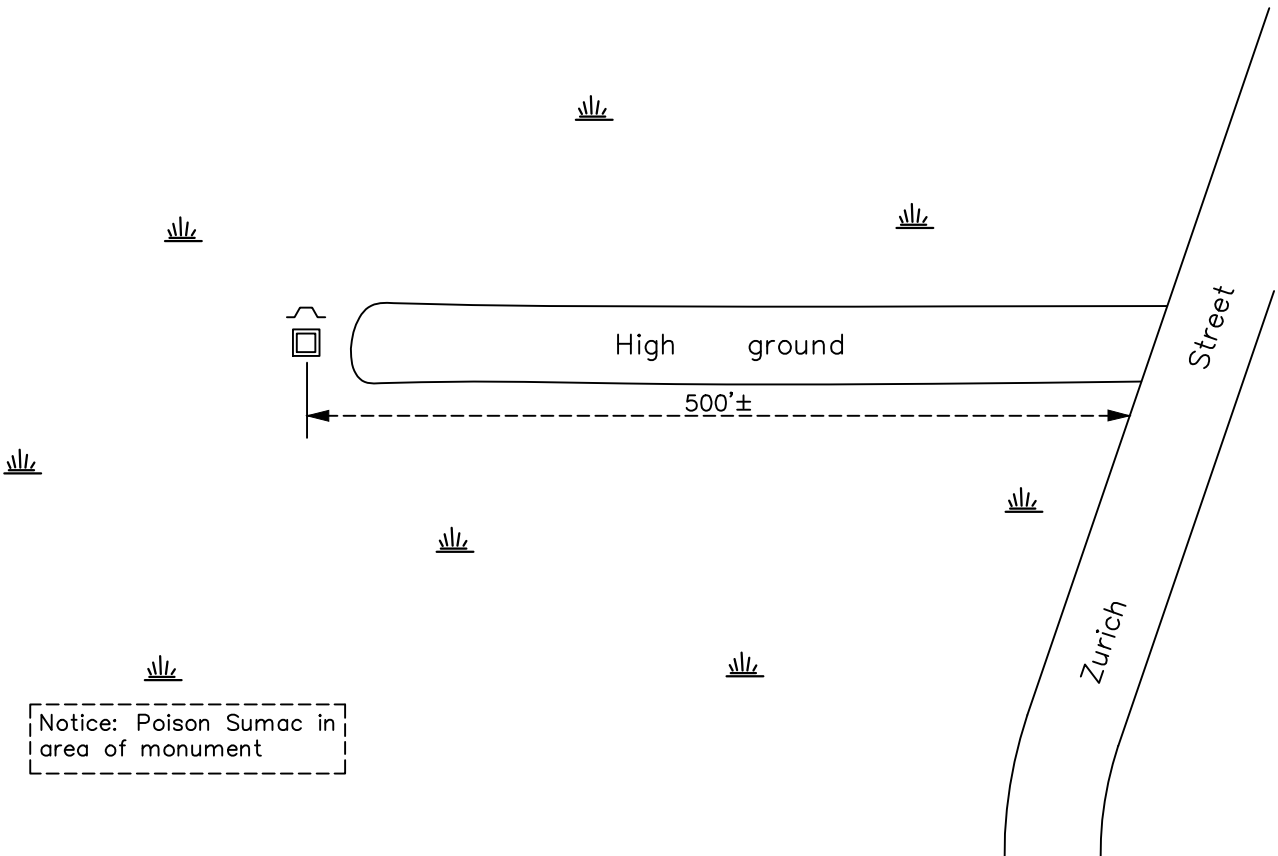

Revision Date  
 6/21/2023

N.A.D. 1983 Coordinates  
 (1996 Adjustment)

County Project Coordinates	
Northing	<u>174635.4729</u>
Easting	<u>558412.7768</u>
Date	<u>1/18/06</u>

I hereby certify that this United States public land survey monument record is correct and complete to the best of my knowledge and belief.  
*David Zieglmeier* Date 12/8/23  
 David Zieglmeier Anoka County Surveyor  
 Minnesota License Number 46179

# HISTORY OF GOVERNMENT CORNER

Page No. 87

County of Anoka

State of Minnesota

## Southwest Corner of Sec. 24 Township 32 Range 22

### **CORNER HISTORY:**

July 20, 1972 - Set red and white iron pipe up 3.5'± using area resurvey. Established ties to pipe.

February 15, 1978 - Found red and white iron pipe. No corner ties.

January 19, 1993 - Found red and white iron pipe. No corner ties.

August 18, 1995 - Found red and white iron pipe. No corner ties.

January 18, 2006 - Found steel Telspar monument w/cap. Established NAD 1983 (1996 adj.) Anoka County project coordinates by static GPS methods. No corner ties.

December 15, 2014 - Found steel Telspar monument w/cap. Verified position by VRS GPS methods. No corner ties.

June 7, 2022 - Found steel Telspar monument w/cap. Verified position by VRS GPS methods. No corner ties.

June 15, 2023 - Found steel Telspar w/ cap up 3'±. Lowered to be up 1.5'± and adjusted to published coordinates using ACS RTK GPS method. No ties available.