

# CERTIFICATE OF LOCATION OF GOVERNMENT CORNER

County of Anoka

State of Minnesota


## North 1/4 Corner of Sec. 36 Township 32 Range 22

On the 2nd day of July, 1974, the described corner was evidenced by area resurvey

and to perpetuate the location of said corner, at the exact location thereof, a permanent marker was placed consisting of a cast iron monument

AND on the 1st day of June, 2022, said permanent marker was found down 0.5± and updated ties. Added sign and post to North side.

Updated reference ties are as shown below.

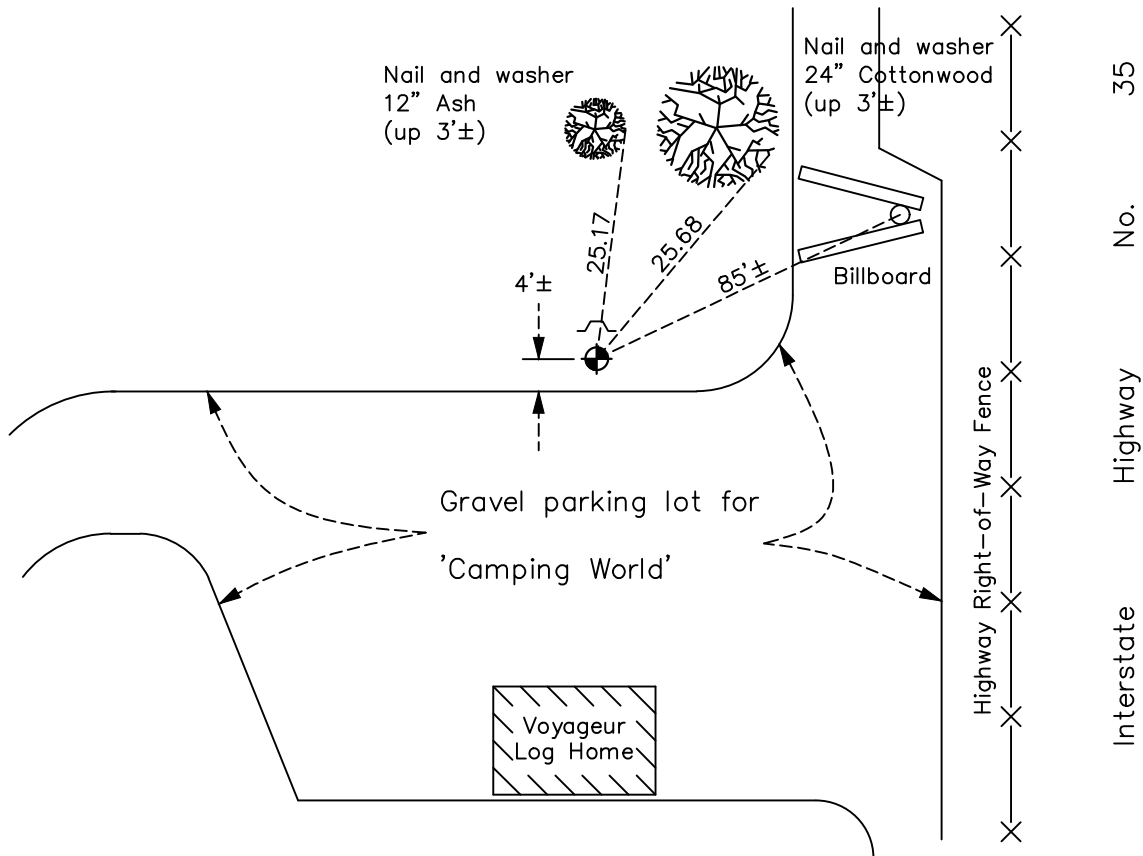

Revision Date  
 12/06/2022

N.A.D. 1983 Coordinates  
 (1996 Adjustment)

County Project Coordinates	
Northing	169372.3434
Easting	561046.7650
Date	5/25/04

I hereby certify that this United States public land survey monument record is correct and complete to the best of my knowledge and belief.  
*David Zieglmeier* Date 12/8/23  
 David Zieglmeier Anoka County Surveyor  
 Minnesota License Number 46179

# HISTORY OF GOVERNMENT CORNER

Page No. 104

County of Anoka

State of Minnesota

## North 1/4 Corner of Sec. 36 Township 32 Range 22

### **CORNER HISTORY:**

July 2, 1974 - Set cast iron monument flush using area resurvey. Established ties to monument.

August 11, 1976 - Found cast iron monument and updated ties.

August 3, 1979 - Found cast iron monument and updated ties.

November 6, 1990 - Found cast iron monument and updated ties.

November 30, 1992 - Found cast iron monument and updated ties.

December 18, 1992 - Found cast iron monument and updated ties.

August 21, 1995 - Found cast iron monument and updated ties.

May 25, 2004 - Found cast iron monument. Updated ties. Established NAD 1983 (1996 adj.) Anoka County project coordinates by static GPS methods.

September 24, 2014 - Found cast iron monument down 1'±. Unable to update ties due to RV's parked around monument.

August 16, 2019 - Found cast iron monument down 0.5'±. Verified position by VRS GPS methods. Unable to update ties due to RV's parked around monument.

June 1, 2022 - Found cast iron monument down 0.5'±. Verified position by VRS GPS methods. Updated ties.