

CERTIFICATE OF LOCATION OF GOVERNMENT CORNER

County of Anoka

State of Minnesota


Northwest Corner of Sec. 36 Township 32 Range 22

On the 6th day of January, 1975, the described corner was evidenced by area resurvey

and to perpetuate the location of said corner, at the exact location thereof, a permanent marker was placed consisting of a red and white 2" iron pipe with a sign attached

AND on the 4th day of March, 2015, said permanent marker was found up 4'± and the ties were updated

Updated reference ties are as shown below.

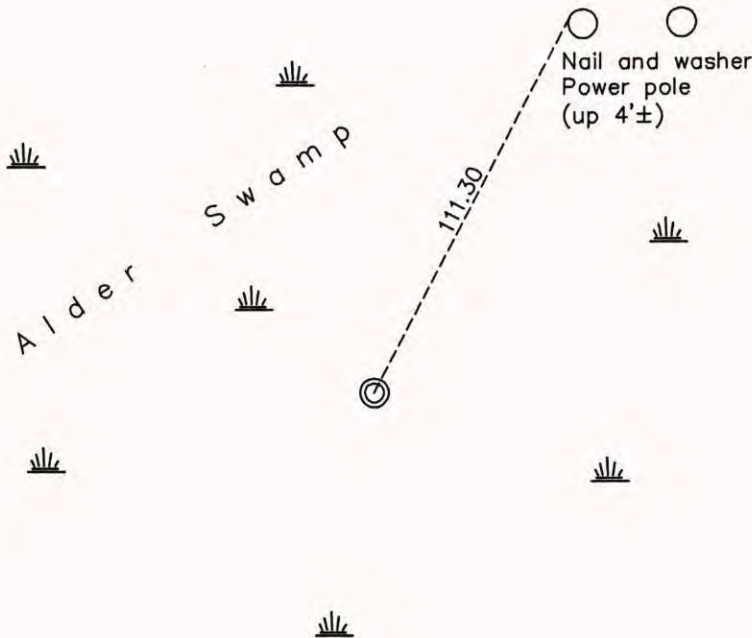

Revision Date

7/17/15

N.A.D. 1983 Coordinates
(1996 Adjustment)

County Project Coordinates

Northing 169393.2427

Easting 558417.2041

Date 1/23/06

I hereby certify that this United States public land survey monument record is correct and complete to the best of my knowledge and belief.

Larry D. Hoium Date 7/17/15

Larry D. Hoium, Anoka County Surveyor

Minnesota License Number 18165