

CERTIFICATE OF LOCATION OF GOVERNMENT CORNER

County of Anoka

State of Minnesota



Northeast Corner of Sec. 31 Township 32 Range 22

On the 7th day of February, 1961, the described corner was evidenced by a reinforced concrete monument

and to perpetuate the location of said corner, at the exact location thereof, a permanent marker was placed consisting of the same concrete monument with a sign and post on the north side

AND on the 9th day of March, 2015, said permanent marker was found broken off and the ties were updated

Updated reference ties are as shown below.

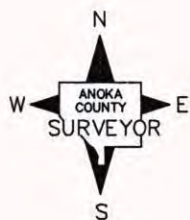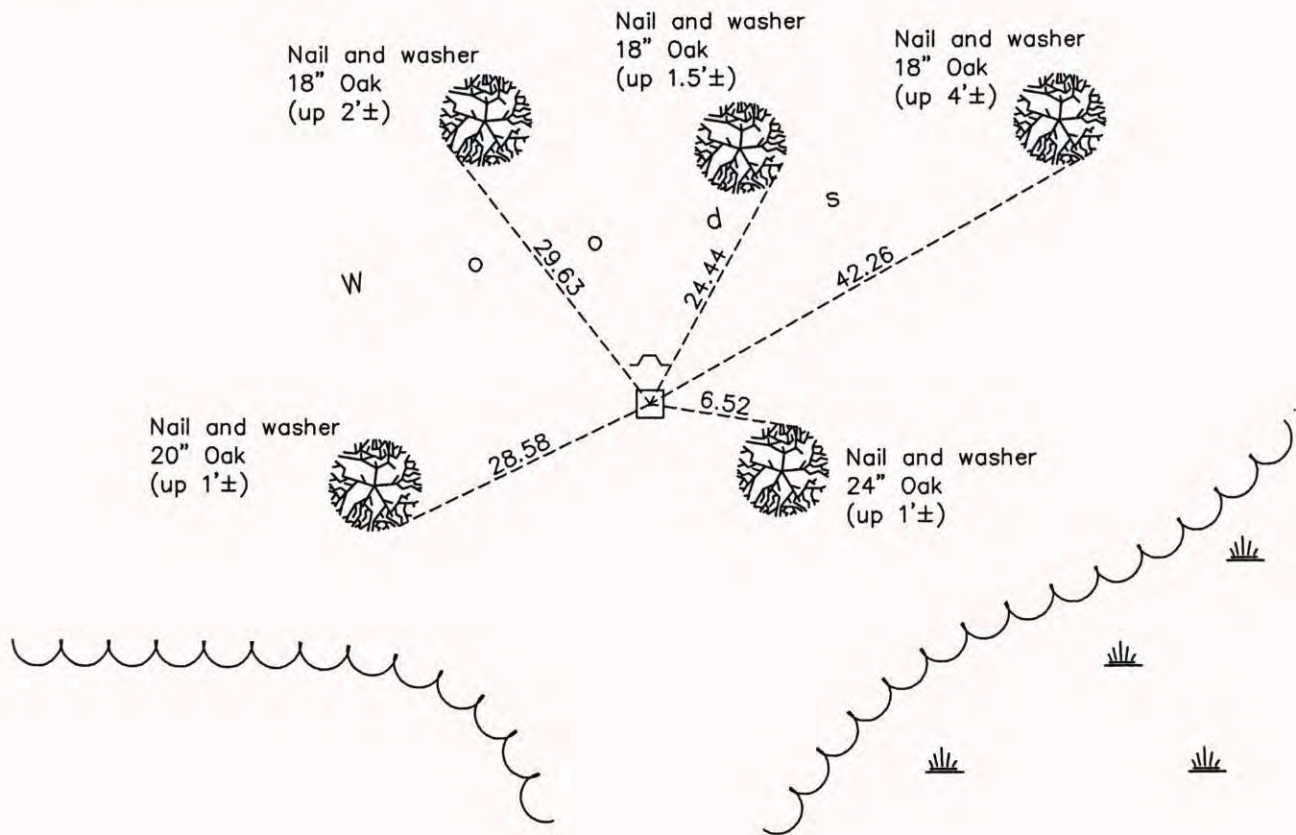

Revision Date
7/22/15

N.A.D. 1983 Coordinates
(1996 Adjustment)

| County Project Coordinates | |
|----------------------------|--------------------|
| Northing | <u>169368.8791</u> |
| Easting | <u>537426.9301</u> |
| Date | <u>2/15/06</u> |

I hereby certify that this United States public land survey monument record is correct and complete to the best of my knowledge and belief.

Larry D. Hoium Date 7/22/15

Larry D. Hoium, Anoka County Surveyor

Minnesota License Number 18165