

CERTIFICATE OF LOCATION OF GOVERNMENT CORNER

County of Anoka

State of Minnesota


West 1/4 Corner of Sec. 35 Township 32 Range 22

On the 14th day of January, 1974, the described corner was evidenced by a 1" iron pipe set by N.C. Hoium

and to perpetuate the location of said corner, at the exact location thereof, a permanent marker was placed consisting of a red and white 2" square steel Telespar monument with a sign attached facing easterly

AND on the 17th day of December, 2014, said permanent marker was found leaning slightly easterly and up 3'±. The ties were updated.

Updated reference ties are as shown below.

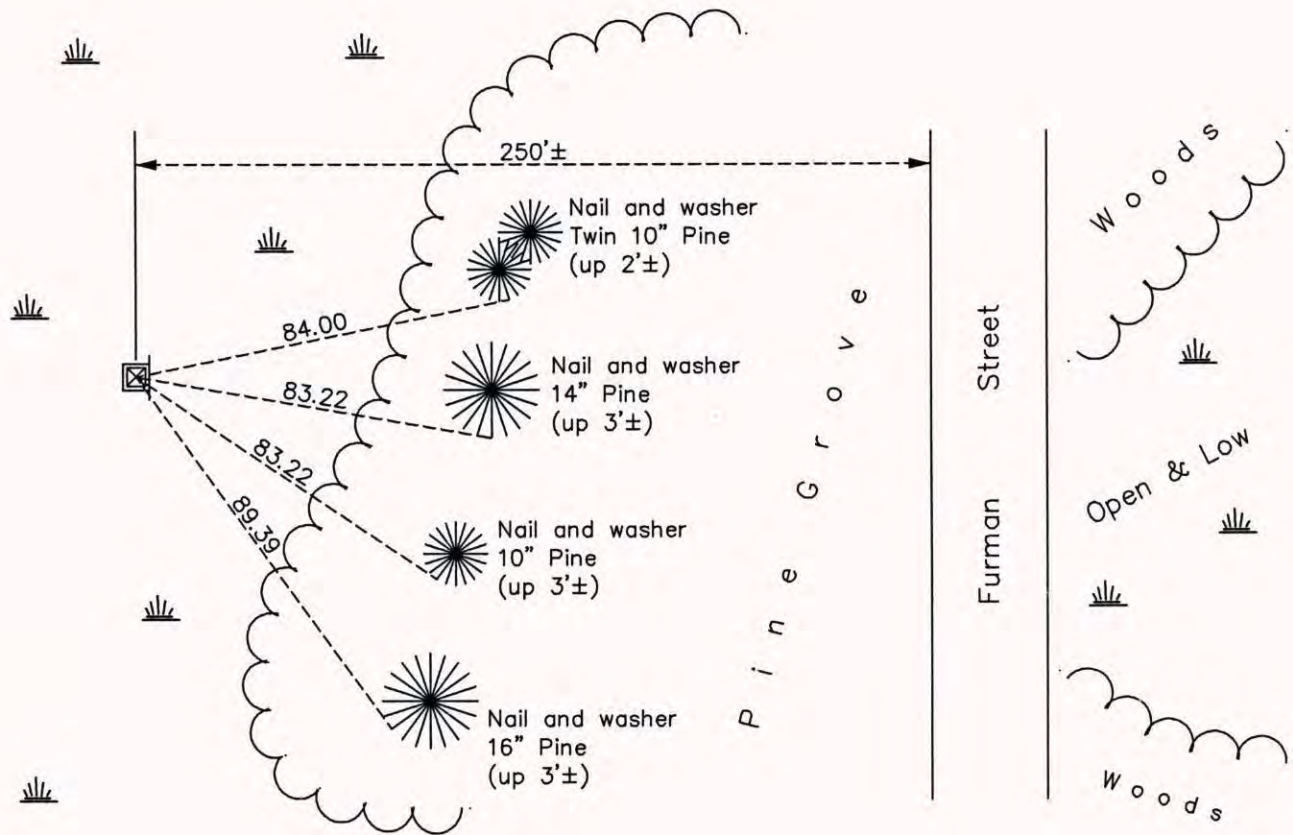

Revision Date

7/28/15

N.A.D. 1983 Coordinates
(1996 Adjustment)

County Project Coordinates

Northing 166802.9263

Easting 553135.4901

Date 1/24/06

I hereby certify that this United States public land survey monument record is correct and complete to the best of my knowledge and belief.

Larry D. Hoium Date 7/28/15

Larry D. Hoium, Anoka County Surveyor

Minnesota License Number 18165