

CERTIFICATE OF LOCATION OF GOVERNMENT CORNER

County of Anoka

State of Minnesota

South 1/4 Corner of Sec. 20 Township 32 Range 22


On the 14th day of February, 2013, the described corner was evidenced by found area
monumentation

and to perpetuate the location of said corner, at the exact location thereof, a permanent marker
was placed consisting of a 2" square steel Telspar monument with a 'County Surveyor' cap.


Set sign and post on the south side.

AND on the ____ day of _____, _____, said permanent marker was _____

Updated reference ties are as shown below.

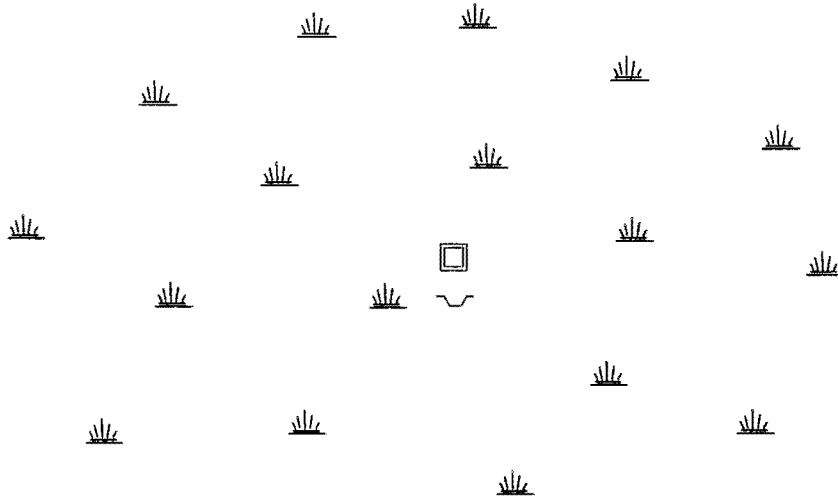

NOTE: There are no physical features available to provide reference ties.

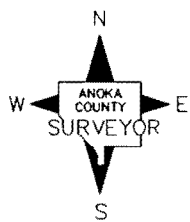

Revision Date
2/25/13

N.A.D. 1983 Coordinates (1996 Adjustment)	
County Project Coordinates	
Northing	<u>174655.4106</u>
Easting	<u>540019.7997</u>
Date	<u>2/14/13</u>

I hereby certify that this United States public land survey monument record is correct and complete to the best of my knowledge and belief.

Larry D. Hoium Date 2/26/13
 Larry D. Hoium, Anoka County Surveyor
 Minnesota License Number 18165

HISTORY OF GOVERNMENT CORNER

Page No. 128

County of Anoka

State of Minnesota

South 1/4 Corner of Sec. 20 Township 32 Range 22

CORNER HISTORY:

January 2013 - Unable to find any evidence of an existing corner monument.

February 14, 2013 - Set 2" square steel Telspar monument in swamp using found iron pipe at southwest corner of SE1/4 of SE1/4 of Section 20 for distance and direction. Extended line between in place Southeast corner of Section 20 and said found iron pipe westerly in a straight line and equal distance to establish location of South 1/4 corner of Section 20. There are no physical features available to provide reference ties. Set a sign and post on the south side of monument.