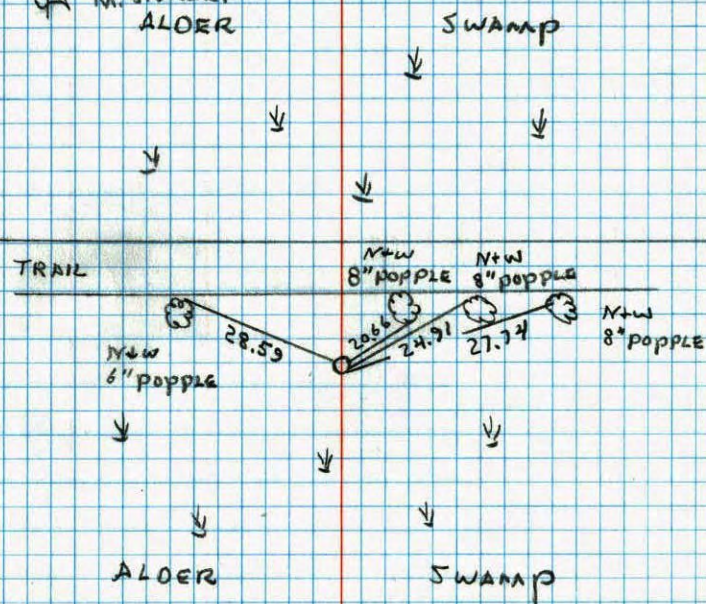


SOUTH 1/4 COR. SECTION 35 T32 R22

RETIED RED AND WHITE IRON PIPE
SIGN ON PIPE10-29-92
H. LARSON
B. KLEML
M. STEWART
ALOER


NO. 448

TELEPHONE

3/4 CORNER SEC. 35 T. 32 R. 22

SET RED AND WHITE IRON PIPE FROM
AREA RE-SURVEY. IRON PIPE UP 2'±.

FOUND 2" IRON PIPE SAME LOCATION

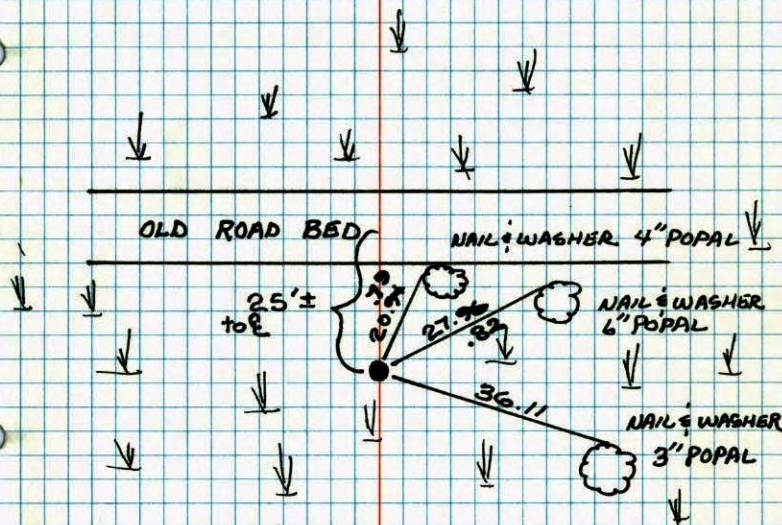12/12/75
H. LARSON
B. GUETZKOTie check
2-15-78
H. Larson
B. GuetzkoTEMPERATURE CORRECTED
AND HORIZONTALLY
TAPED MEASUREMENTSROLAND W. ANDERSON
COUNTY SURVEYOR
ANOKA COUNTY, MINNESOTA

5/4 Cor. Sec. 35 T32 R22

Set red + white iron pipe From area
resurvey. I.P. up 2'±

Found 2" I.P. SAME LOCATION
20° * 11
12-12-75
H. Larson
B. Guetako

