


W $\frac{1}{16}$ Cor. - SW $\frac{1}{4}$ Sec 2 - T32-R22

Ties Taken by Jim Kurth, Apr 1968

P.K. On E

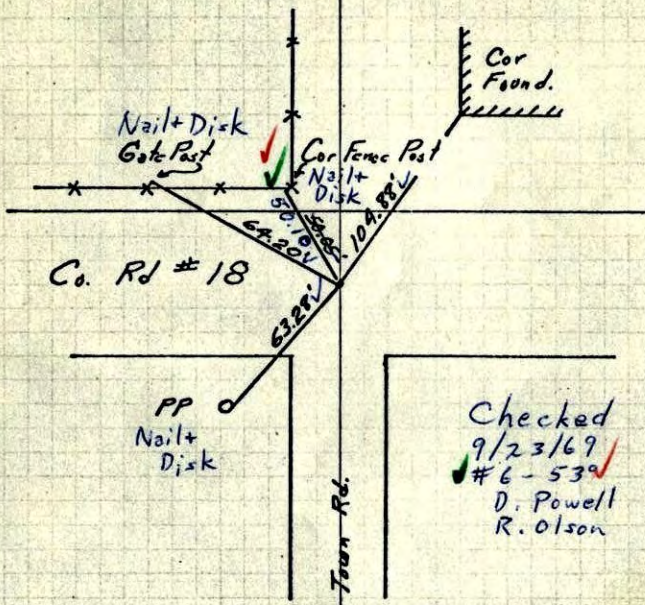

Checked
9/23/69
#6 - 530
D. Powell
R. Olson