

CERTIFICATE OF LOCATION OF GOVERNMENT CORNER

County of Anoka

State of Minnesota


Southeast Corner of Sec. 9 Township 32 Range 22

On the 18th day of September, 1964, the described corner was evidenced by a solid iron bar

and to perpetuate the location of said corner, at the exact location thereof, a permanent marker was placed consisting of a cast iron monument

AND on the 14th day of November, 2007, said permanent marker was found and the ties were updated

Updated reference ties are as shown below.

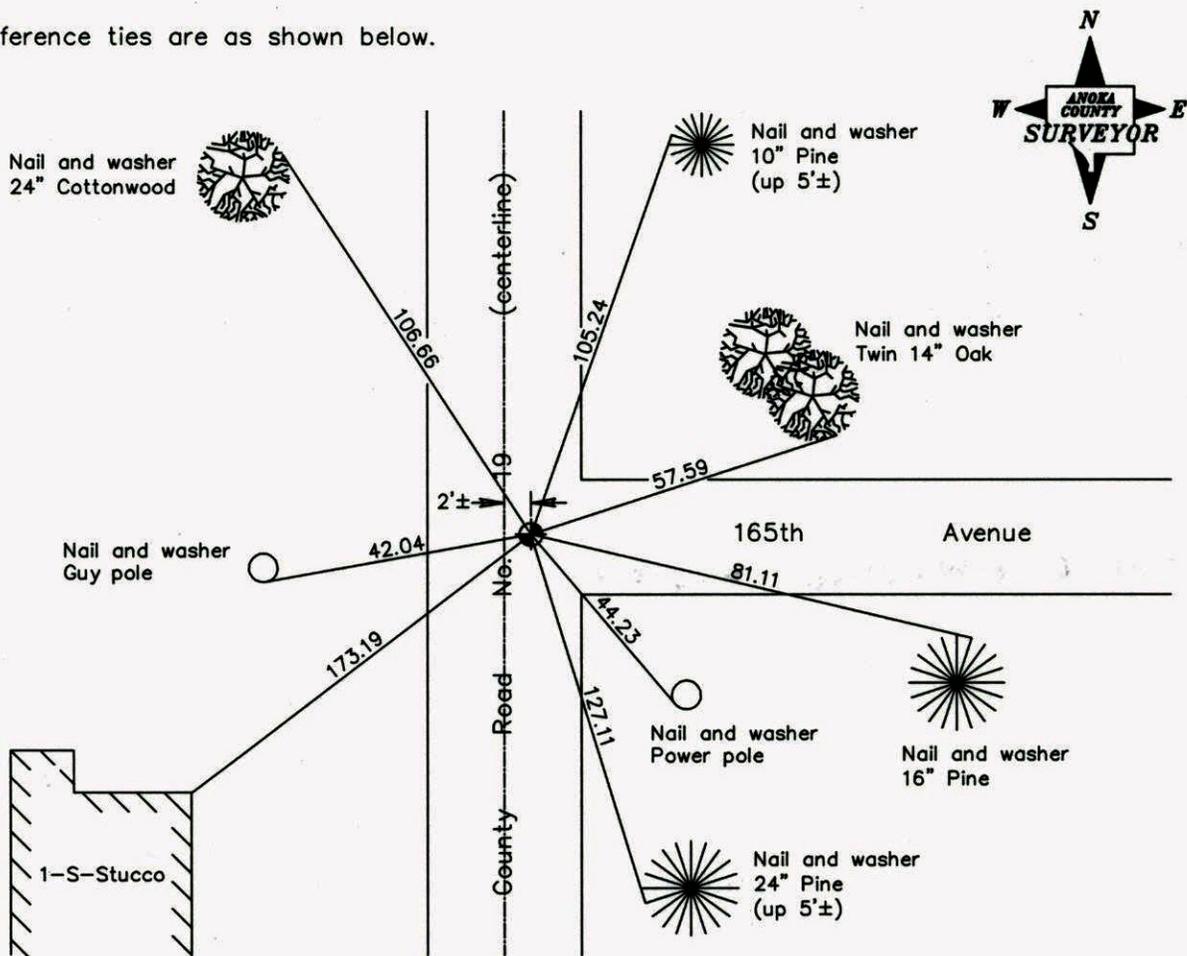

Revised date

8/14/95
8/26/97
11/14/07

N.A.D. 1983 Coordinates
(1996 Adjustment)

County Project Coordinates	
Northing	<u>185222.9519</u>
Easting	<u>547963.5435</u>
Date	<u>6/23/03</u>

I hereby certify that this United States public land survey monument record is correct and complete to the best of my knowledge and belief.

Larry D. Hoium Date 11/14/07
 _____, Anoka County Surveyor
 Minnesota License Number 18165

CERTIFICATE OF LOCATION OF GOVERNMENT CORNER

County of Anoka


State of Minnesota

SOUTHEAST Corner of Sec. 9 Township 32 Range 22


I hereby certify that on the 18 day of SEPT., 1964, I found the described corner which was evidenced by SOLID IRON BAR

and I further certify that to perpetuate the location of said corner, I did, at the exact location thereof, place a permanent marker consisting of CAST IRON MON.

which reference or witness monuments are located in the manner following:

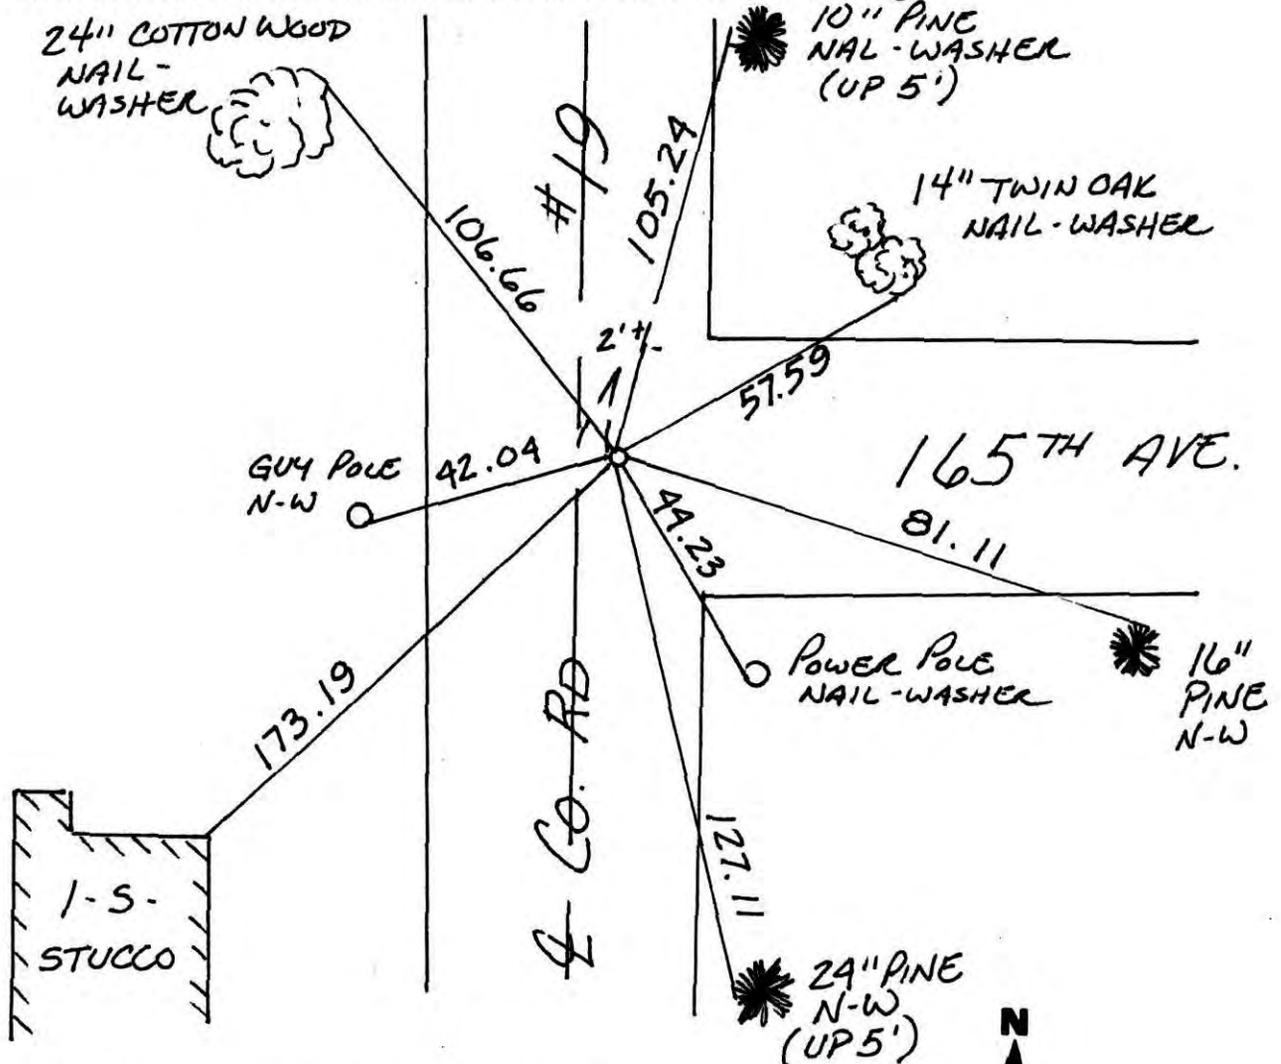

Revised date	Revised date	Revised date
6 28 90		
8 14 95		
8 26 97 (REPLCD)		
11-14-07		

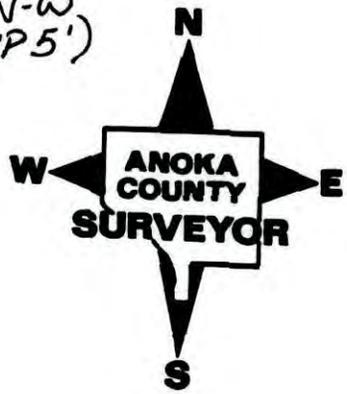

CERTIFICATE OF LOCATION OF GOVERNMENT CORNER

County of Anoka


State of Minnesota

SOUTHEAST Corner of Sec. 9 Township 32 Range 22


I hereby certify that on the 18TH day of SEPT., 19 64, I found the described corner which was evidenced by SOLID IRON BAR

and I further certify that to perpetuate the location of said corner, I did, at the exact location thereof, place a permanent marker consisting of CAST IRON MONUMENT


which reference or witness monuments are located in the manner following:

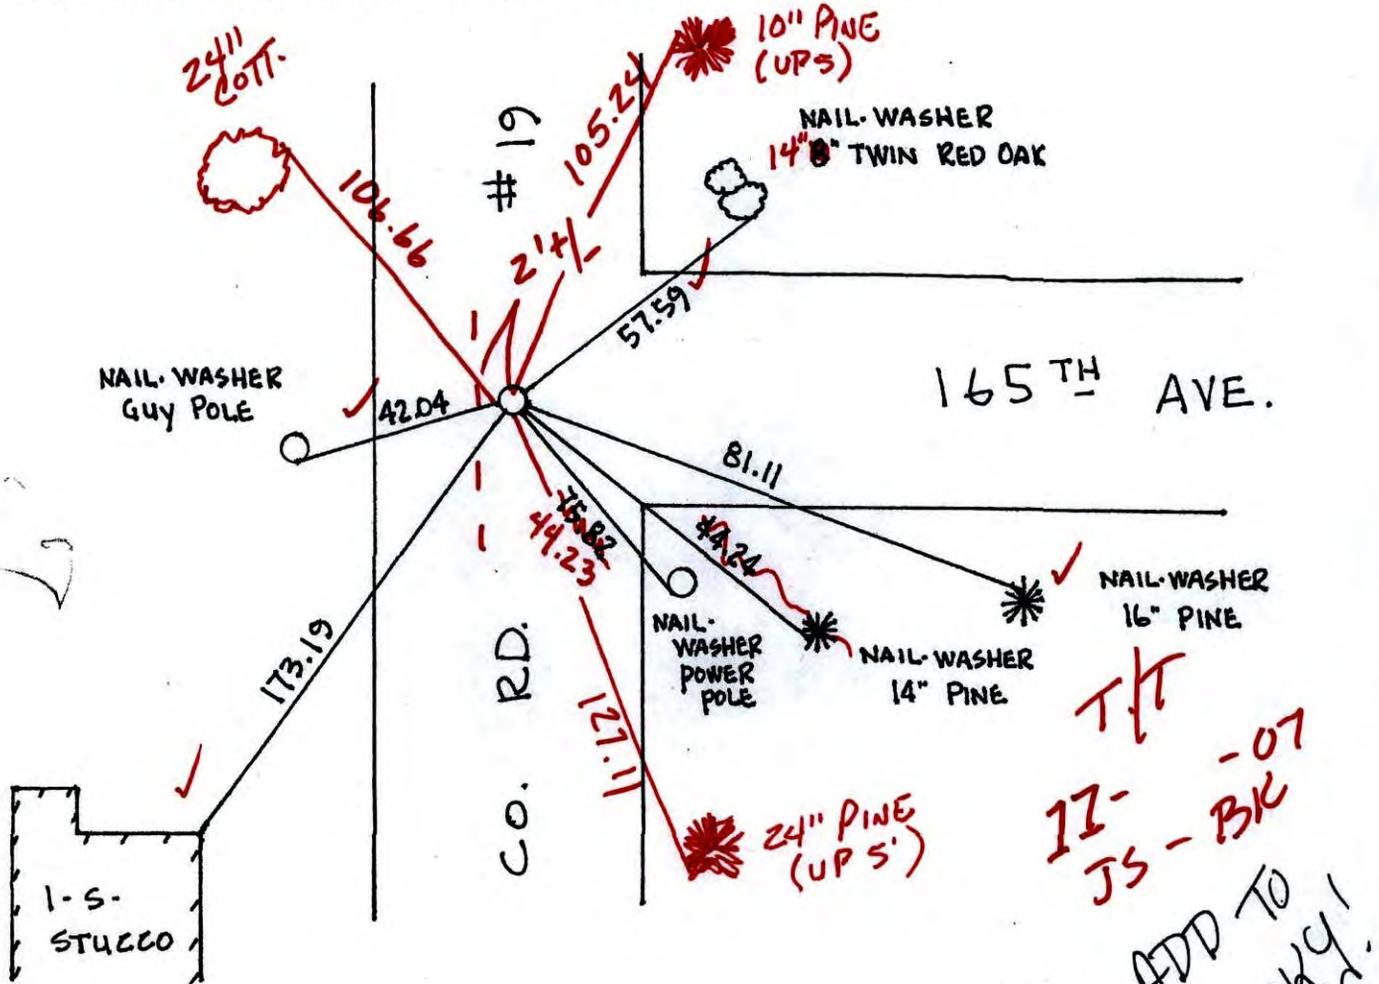

Revised date	Revised date	Revised date
6-28-90		
8-14-95		
REPLACED 8-26-97		

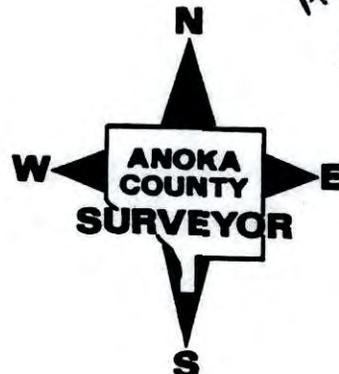


CONSTRUCTION TIES
S.E. COR. SEC 9 T32 R22

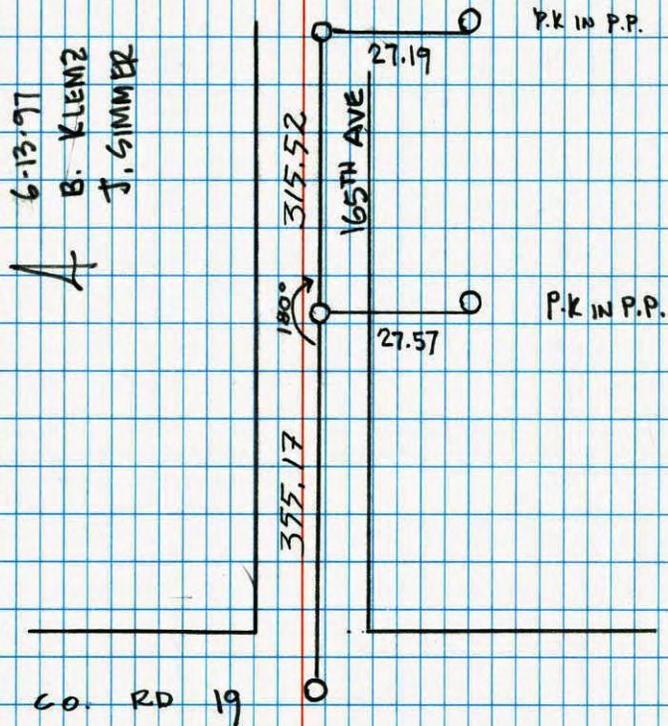

NO. 448

NATIONAL PRINTER

Southeast Corner Sec. 9 T32 R22
Retied Cast Iron Monument

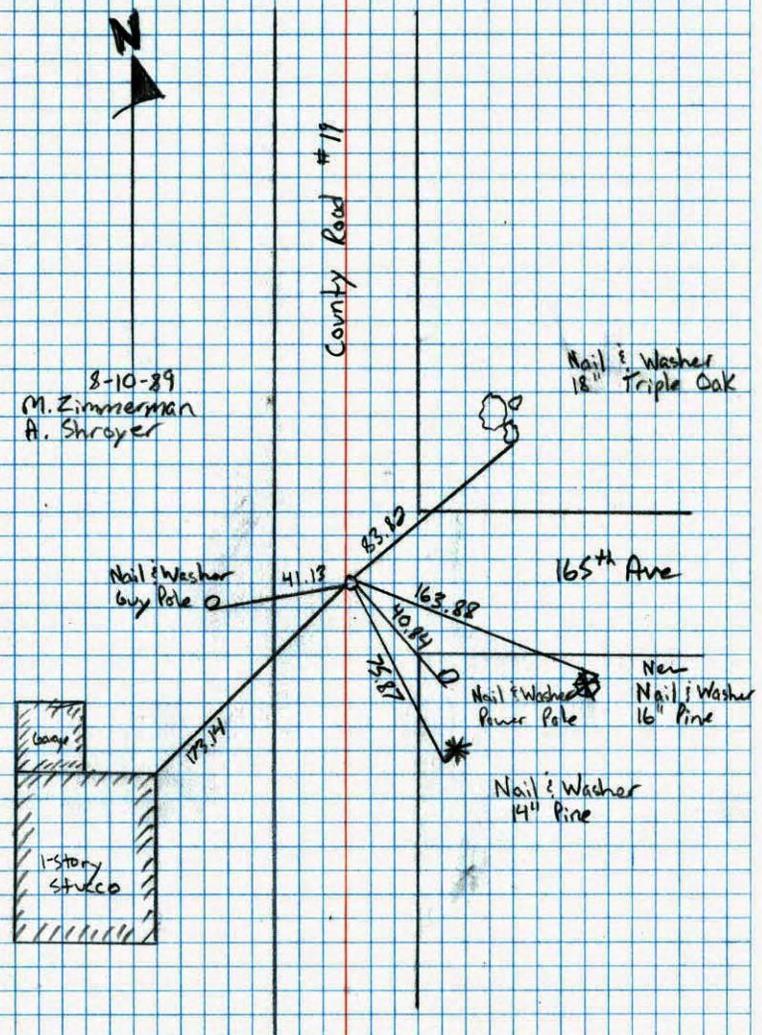


NO. 448

NATIONAL PRINTER

S. E. Cor. Sec. 9, T 32, R. 22

~~1/2" Iron pipe flush, solid iron bar under iron pipe~~
 Set Cast Iron Monument flush on top of
 Iron Bar. PK's 2.00' North + East.
 Sept. 8, 1969
 D. Powell
 R. Olson
 B. Olson

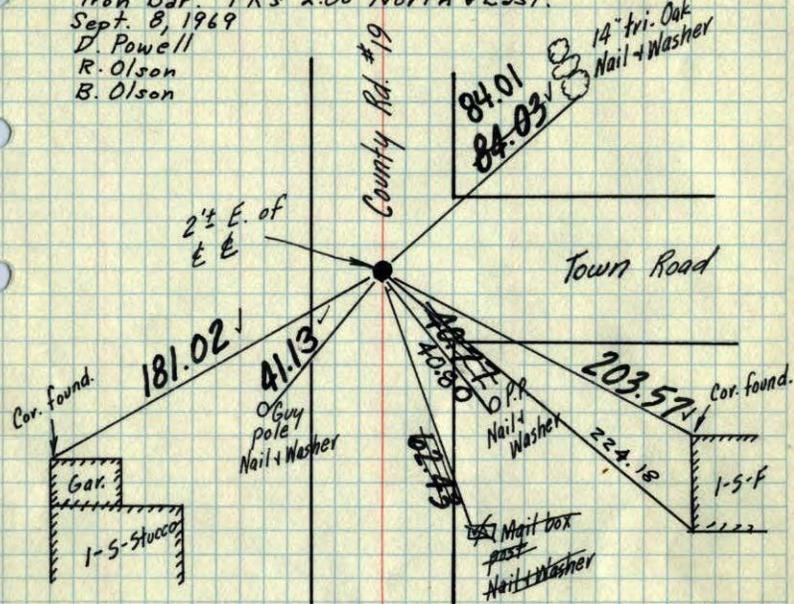

TIE CHECK
 8-1-79
 B. STEPHENS
 D. STEPHENS
 P. ROSS

Ties Checked
 June 5, 1973
 B. Olson
 D. Brien
 D. Farmer
 TIE CHECK
 8-5-76
 G. ADAMS
 S. BRIEN
 J. STEPHENS

Sept. 18, 64


M. D. Anderson
 J. Oliver
 G. Mills

TEMPERATURE CORRECTED
 AND HORIZONTALLY
 TAPED MEASUREMENTS

ROLAND W. ANDERSON
 COUNTY SURVEYOR
 ANOKA COUNTY, MINNESOTA

S. E. Cor. Sec. 9, T 32, R. 22

~~1/2" Iron pipe flush, solid iron bar under iron pipe~~
 Set C.I. Mon. flush on top of
 iron bar. PK's 2.00' N+E
 9/8/69
 #9-63
 D. Powell
 R. Olson
 B. Olson

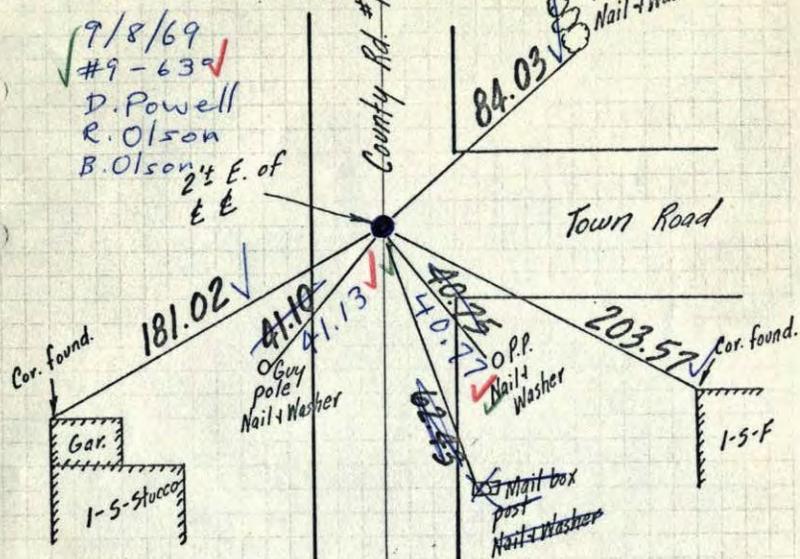

Sept. 18, 64

M. D. Anderson
 J. Oliver
 G. Mills

TEMPERATURE CORRECTED
 AND HORIZONTALLY
 TAPED MEASUREMENTS

ROLAND W. ANDERSON
 COUNTY SURVEYOR
 ANOKA COUNTY, MINNESOTA

