

# CERTIFICATE OF LOCATION OF GOVERNMENT CORNER

County of Anoka                      State of Minnesota


West 1/4 Corner of Sec. 16 Township 32 Range 22

On the 28th day of October, 1971, the described corner was evidenced by a concrete monument

and to perpetuate the location of said corner, at the exact location thereof, a permanent marker was placed consisting of the same concrete monument with a sign and post on the east side and a steel post on the west side (SIGN AND POST FACING W.)

AND on the 21st day of February, 2006, said permanent marker was found and the ties were checked

Updated reference ties are as shown below.

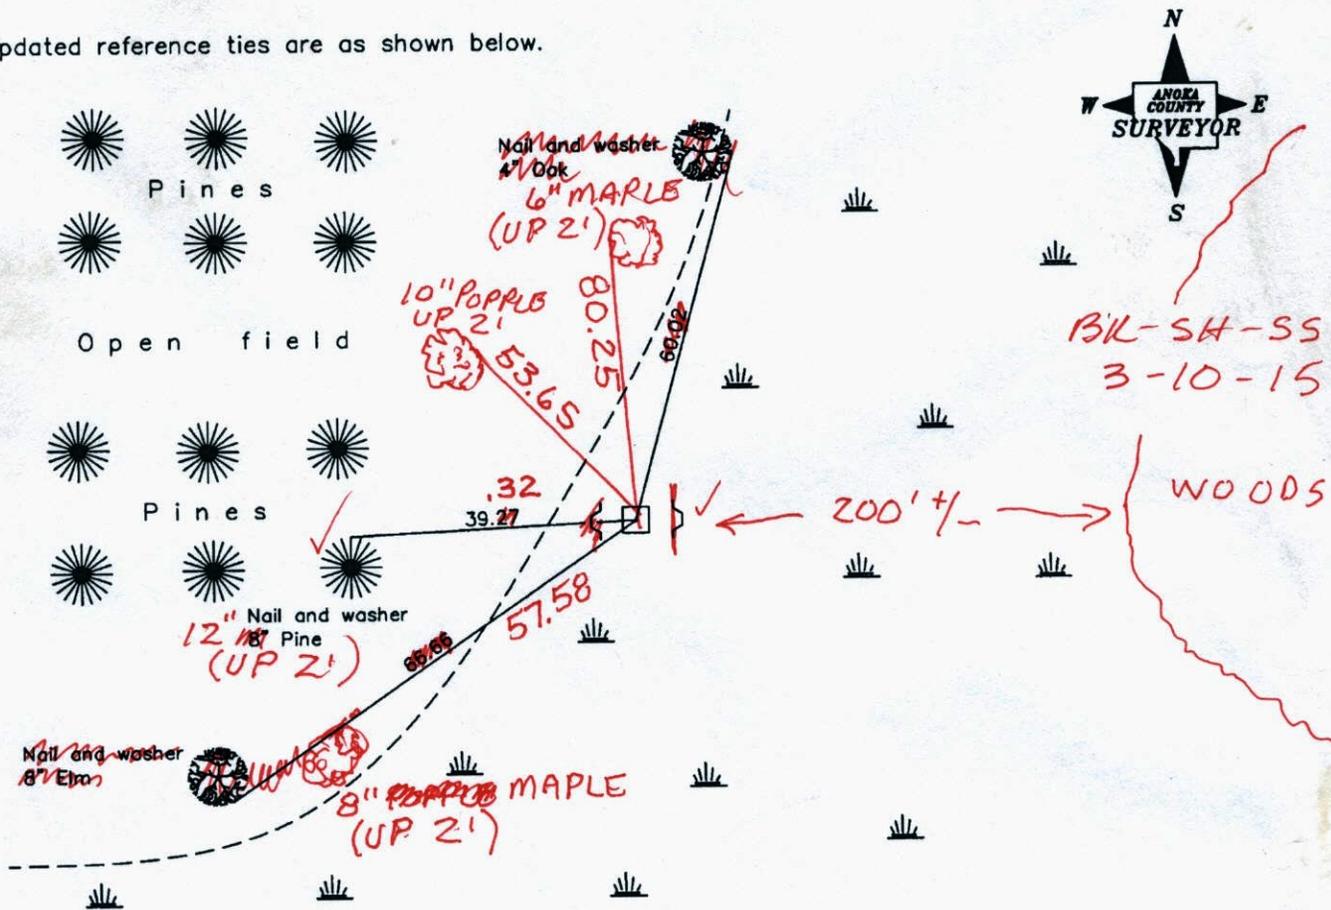

Revised date

8/23/95
3/19/97
2/21/06

N.A.D. 1983 Coordinates  
(1996 Adjustment)

County Project Coordinates	
Northing	182570.9529
Easting	542724.6009
Date	2/21/06

I hereby certify that this United States public land survey monument record is correct and complete to the best of my knowledge and belief.

*Larry D. Hoium* Date 2/21/06  
 Larry D. Hoium, Anoka County Surveyor  
 Minnesota License Number 18165

3D=0.05

N=182570.9209

E=542724.5934

# CERTIFICATE OF LOCATION OF GOVERNMENT CORNER

County of Anoka

State of Minnesota


West 1/4 Corner of Sec. 16 Township 32 Range 22

On the 28th day of October, 1971, the described corner was evidenced by a concrete monument

and to perpetuate the location of said corner, at the exact location thereof, a permanent marker was placed consisting of the same concrete monument with a sign and post on the east side and a steel post on the west side

AND on the 21st day of February, 2006, said permanent marker was found and the ties were checked

Updated reference ties are as shown below.

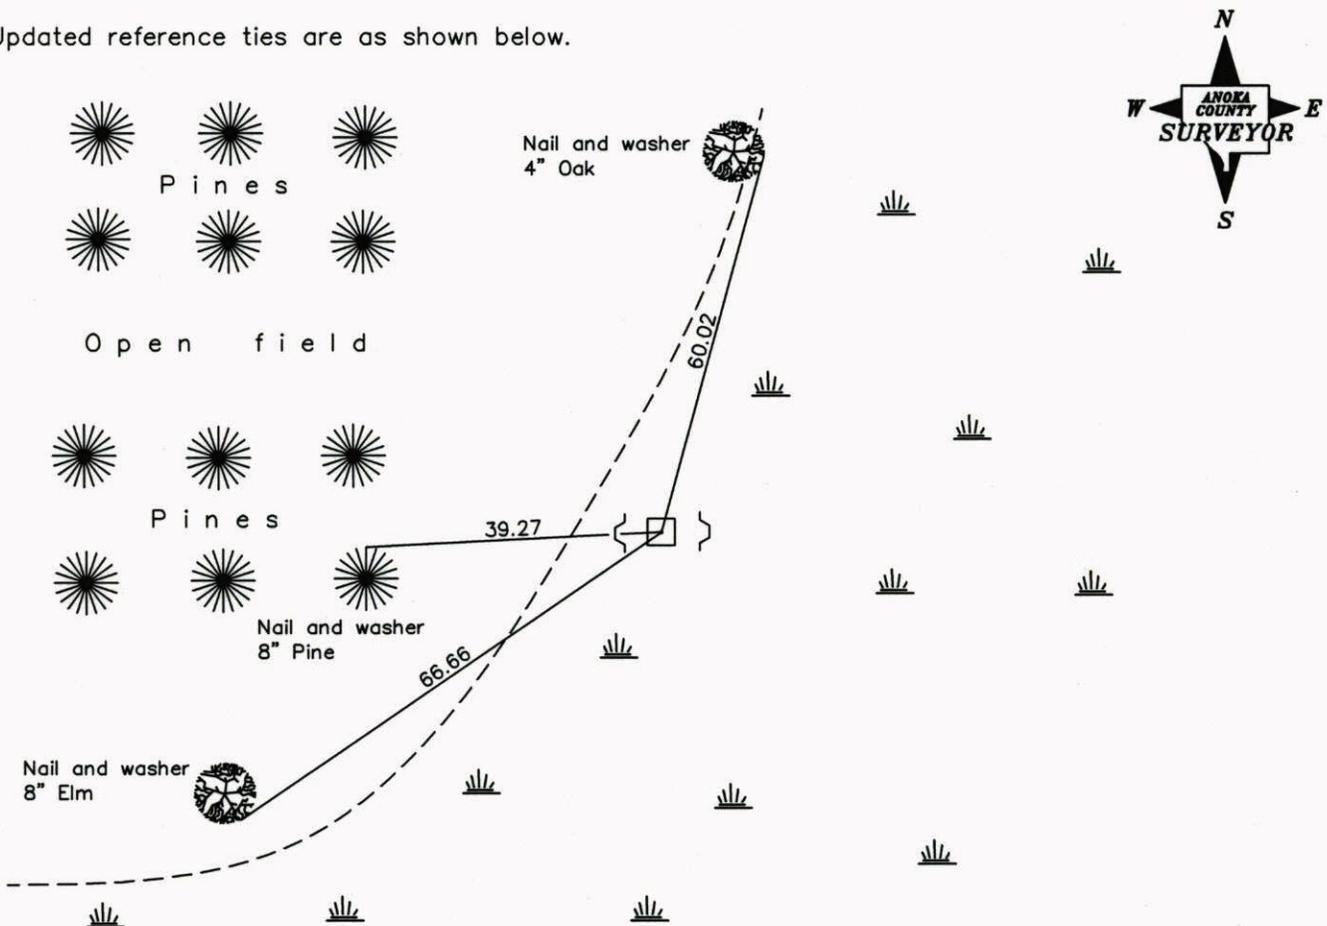

Revised date
8/23/95
3/19/97
2/21/06

N.A.D. 1983 Coordinates (1996 Adjustment)	
County Project Coordinates	
Northing	<u>182570.9529</u>
Easting	<u>542724.6009</u>
Date	<u>2/21/06</u>

I hereby certify that this United States public land survey monument record is correct and complete to the best of my knowledge and belief.

*Larry D. Hoium* Date 2/21/06

\_\_\_\_\_  
Larry D. Hoium, Anoka County Surveyor

Minnesota License Number 18165

# CERTIFICATE OF LOCATION OF GOVERNMENT CORNER

County of Anoka


State of Minnesota

WEST QTR. Corner of Sec. 16 Township 32 Range 22


I hereby certify that on the 28 day of OCT., 19 71, I found the described corner which was evidenced by CONCRETE MON.

and I further certify that to perpetuate the location of said corner, I did, at the exact location thereof, place a permanent marker consisting of SAME SIGN AND POST  
ON EAST SIDE STEEL POST ON WEST SIDE

which reference or witness monuments are located in the manner following:

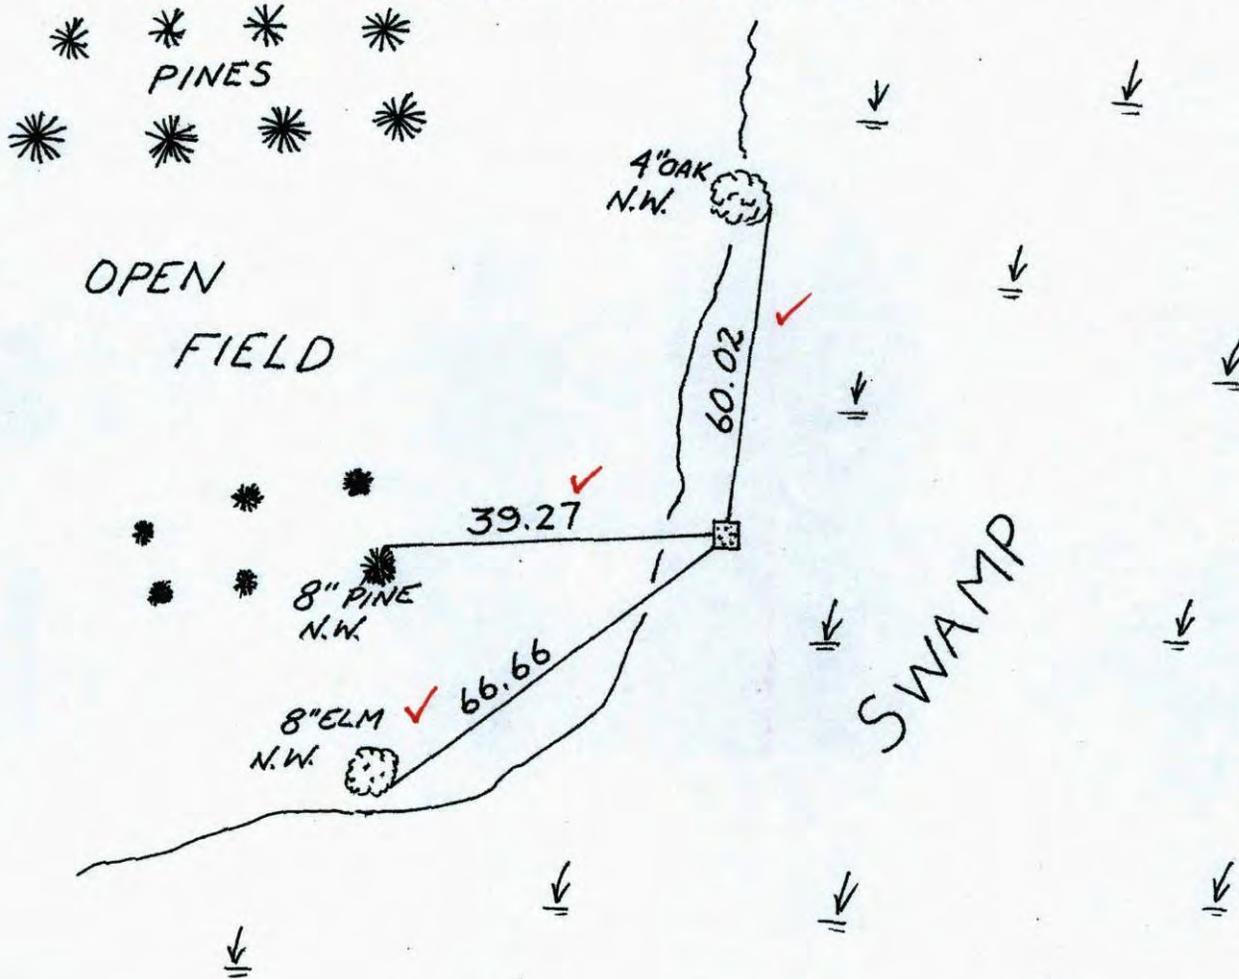

Revised date	Revised date	Revised date
8-23-95		
3-19-97		

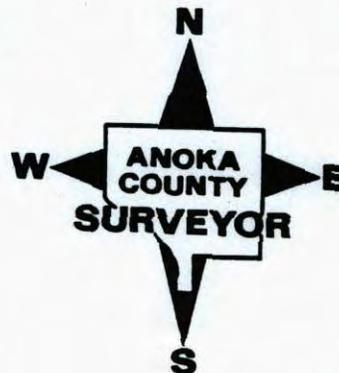

# CERTIFICATE OF LOCATION OF GOVERNMENT CORNER

County of Anoka


State of Minnesota

WEST QTR. Corner of Sec. 16 Township 32 Range 22


I hereby certify that on the 28 day of OCT., 1971, I found the described corner which was evidenced by CONCRETE MON.

and I further certify that to perpetuate the location of said corner, I did, at the exact location thereof, place a permanent marker consisting of SAME SIGN AND POST  
ON EAST SIDE STEEL POST ON WEST SIDE

which reference or witness monuments are located in the manner following:

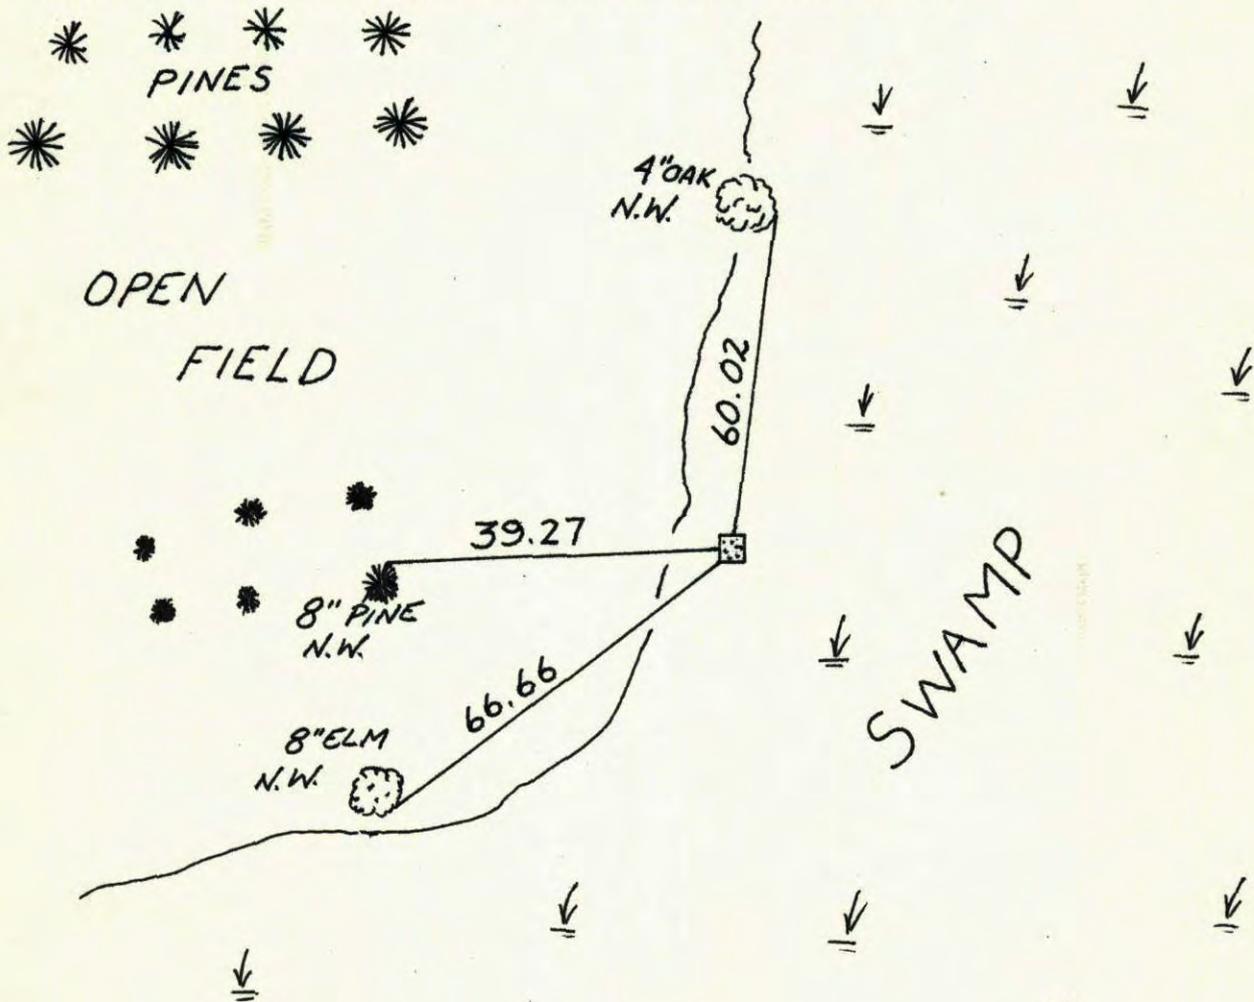


Revised date	Revised date	Revised date
8-23-95		
3-19-97		

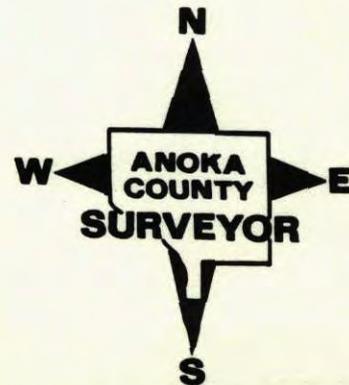


W<sup>1</sup>/<sub>4</sub> COR. SECTION 16 T32 R22

FOUND AND TIED CONCRETE MONI  
PLACED SIGN + POST ON EAST SIDE  
STEEL POST ON WEST SIDE

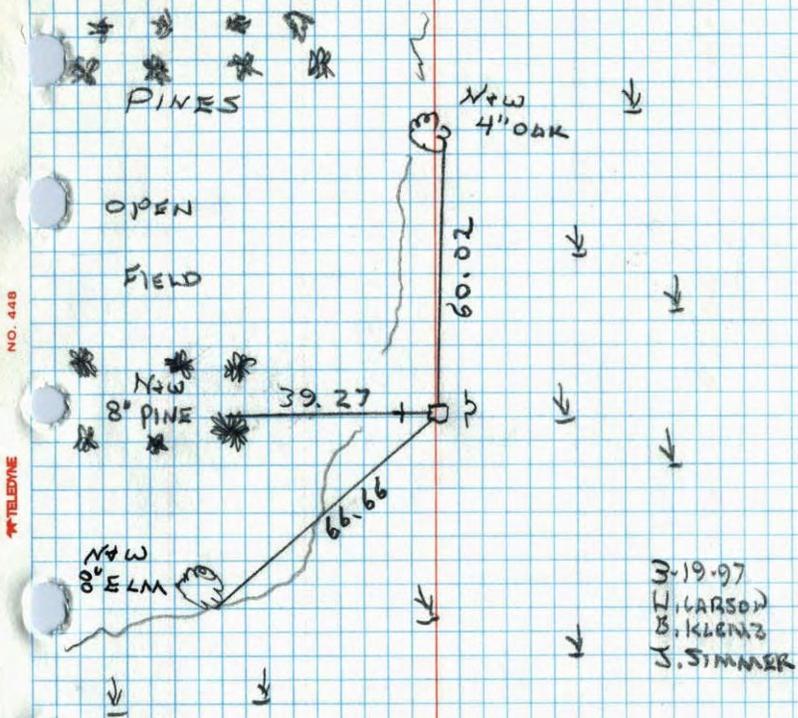

W<sup>1</sup>/<sub>4</sub> Cor. Sec. 16-T32-R22  
Found Conc. Monument up 0.8'

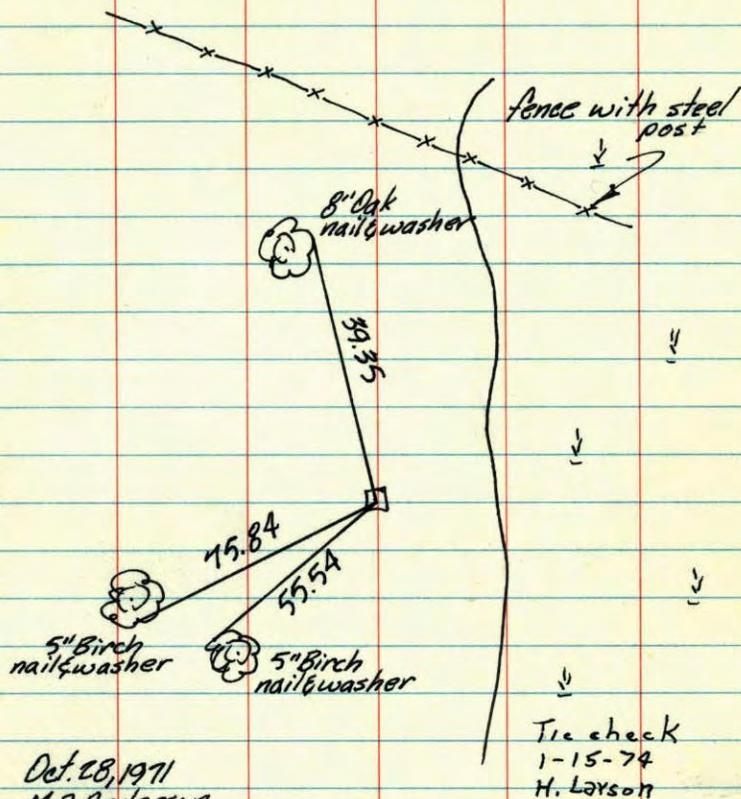

Oct. 28, 1971  
M.D. Anderson  
R. Bertleson  
G. Boetcher


TEMPERATURE CORRECTED  
AND HORIZONTALLY  
TAPED MEASUREMENTS

ROLAND W. ANDERSON  
COUNTY SURVEYOR  
ANOKA COUNTY, MINNESOTA

Field Sheet

W/4Cor Sec 16 T32 R22

Found and Tied concrete mon.  
mon is up .8 ±

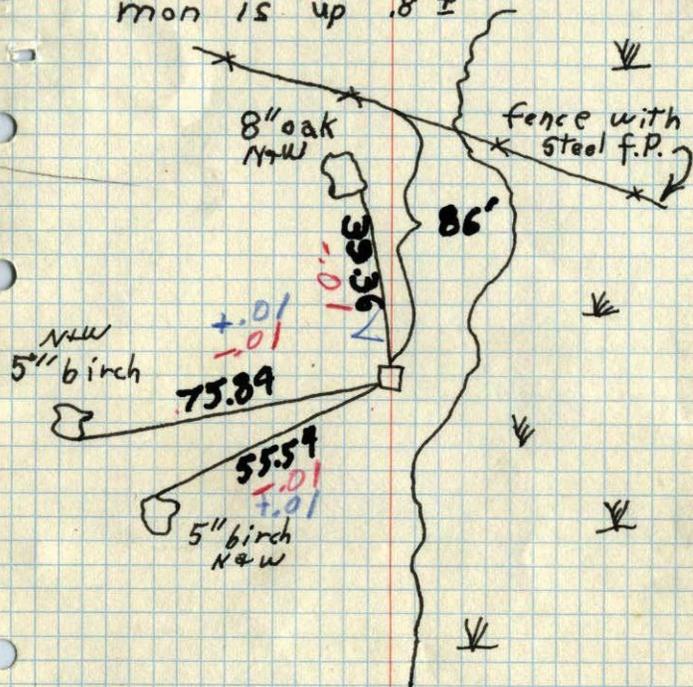

Oct 28, 1971  
M.D. ANDERSON  
P. Beattleson  
G. Boettcher

Temp 45°  
Taps #11