



4"x4" conc. 1' up  
 top 8" broken off  
 two refuge signs  
 bent over  
 near SW side small  
 open slough

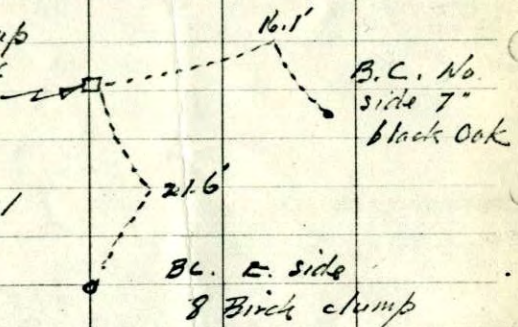

T 22  
 R 22

SE cor. NW 1/4 SE 1/4 Sec. 30  
 Mar. 1966

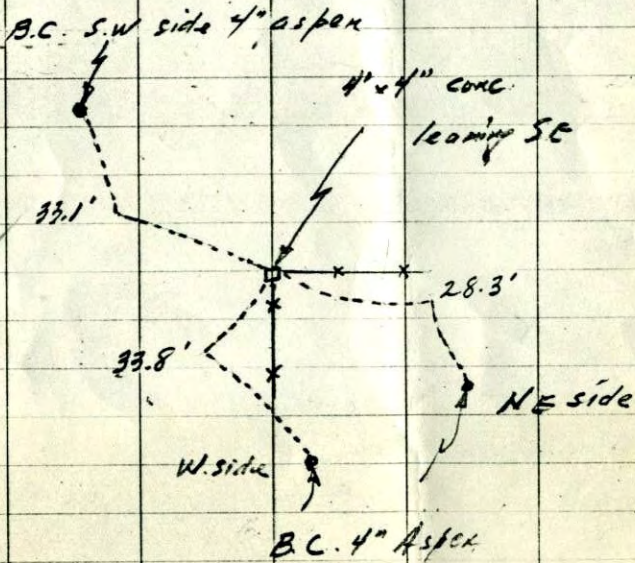

T 22  
 R 22

SE cor NE 1/4 SW 1/4 Sec. 30  
 Mar. 1966

Check Hwy. Books

1. SUR. sec. 30, T32 R22 P.74 B.19  
 2. sec. ties job 2202 P78 B21